

E 24

11-10-64

WATER WELL DRILLERS LOG

Date: Nov 10, 1964, Driller: Joe Miller County: Hancock  
(Name)

(1) Owner of Land: J. Q. Ladner  
(Name)  
RR # Pass Christian  
(Address)

(2) Location: 1/4, 1/4, Sec.     T     R      
15 miles North, of Pass Christian  
(distance) (direction) (Nearest Town)

(3) Topography: Hilly  
(Hilly) (Flat) (Level)

(4) Purpose of Well: Domestic  
(Domestic Irrigation Municipal, Industrial, Other)

Description & Color of Materials Sand, Clay, Red Clay, Shell, etc.	Thick- ness Feet	Depth Feet
Red Sand + Red Clay	30	30
Light to Small Gravel	15	45
"	25	70
Brown Sand + Gravel	26	96
Purple Clay Red Clay	10	106
Wh Clay	20	126
Softer	19	145
Snaky Cap Rock	1	146
White Clay	2	148
White Clay Red Clay	31	179
Blue Clay (Hard)	81	260
Softer	10	270
Hard Blue Clay	66	336
Br. Fine Sand	19	355
Cap Rock	1	356
Softer	12	368
Diff. (No show)	6	375
Cap Rock	1	376
Sand - Fair	4	380
Sand + P Gravel	10	390
" " "	8	398
Hard. Broken Rock	4	402

Information upon completion of well:

(1) Diameter 2 inches.

(2) Total Depth 402 feet.

(3) Water Level 105' feet below top of ground.

(4) Cased to 388', Size 2"


(5) Screen: Size 2", Length 10'

(6) Were any formations sealed against pollution?  
    yes,     no.

If YES depth of formation    


Why    

Drillers Remarks:    

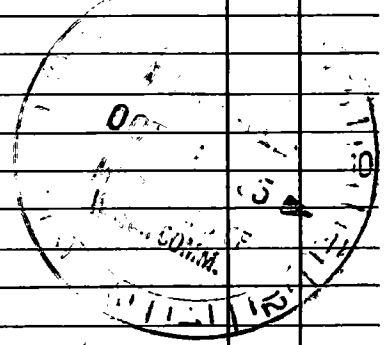

(Use Back Side)

Well No.

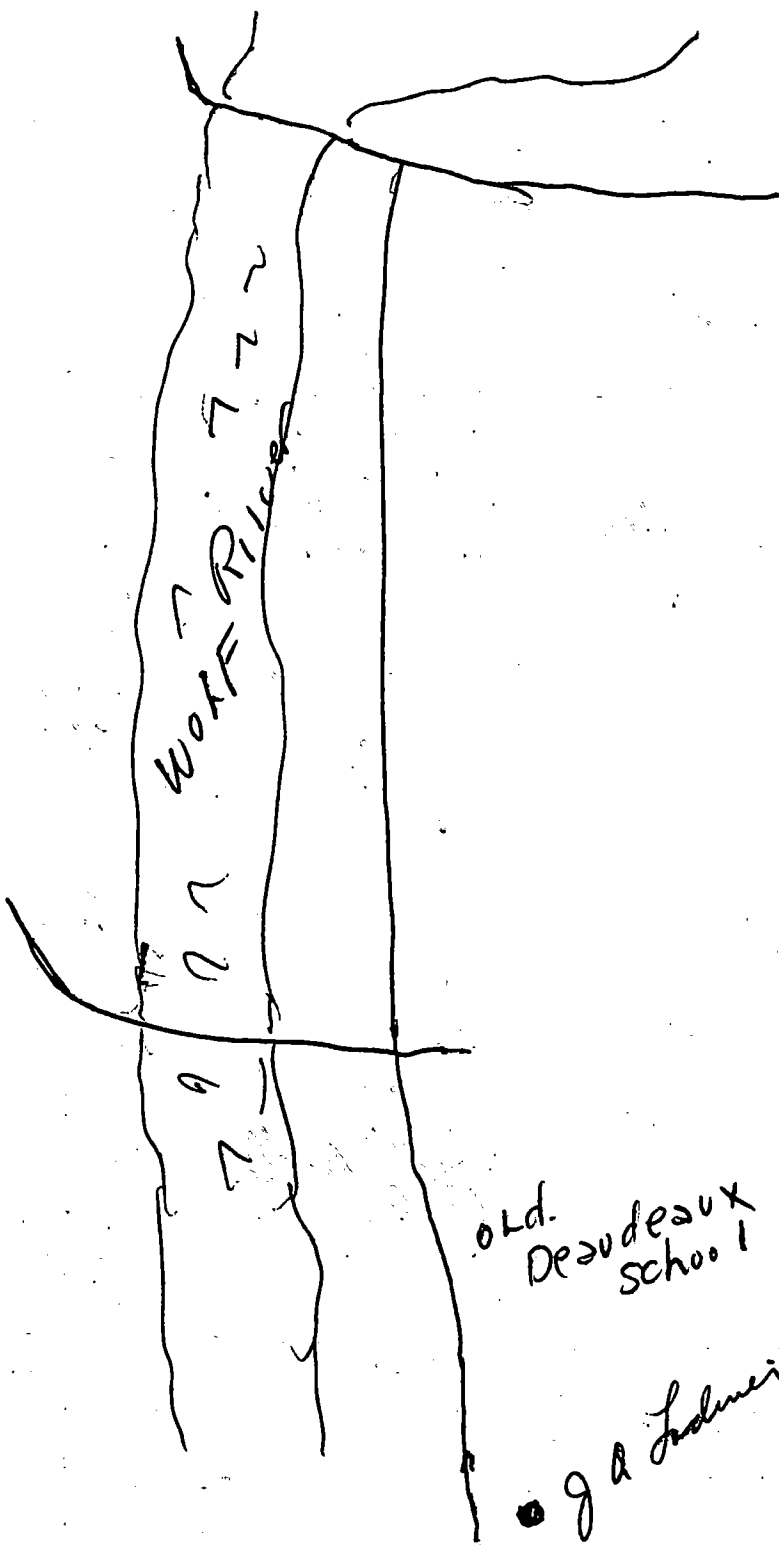

WOLF RIVER

Old.  
Desjodeaux  
School

J. A. Holmes