

HAR.

E25

WATER WELL DRILLERS LOG

CODED

Date: 12-23-64, Driller: J. Reed, County: Adams

(Name)

(1) Owner of Land: D. R. Ladner (Name)
RT 2 Box 269 Sulphur (Address)
(2) Location: NW 1/4, NE 1/4, Sec. 19 T6R12 (distance) miles (direction) of (Nearest Town)
(3) Topography: (Hilly) (Flat) (Level)
(4) Purpose of Well: Home (Domestic Irrigation Municipal, Industrial, Other)


Table with 3 columns: Description & Color of Materials, Thickness Feet, Depth Feet. Rows include: White mud & chalk (63, 63), White cone sand (63, 126), Hard Blue mud (42, 168), Fine Blue sand (84, 252), Soft Blue mud (63, 315), Water sand (42, 357)

CODED

Information upon completion of well:

(1) Diameter: 2 x 1/4 inches.
(2) Total Depth: 357 feet.
(3) Water Level: 52 feet below top of ground.
(4) Cased to: Size:
(5) Screen: Size: 1/4, Length: 15 ft.
(6) Were any formations sealed against pollution? Back filled with sand

If YES depth of formation
Why
Drillers Remarks:

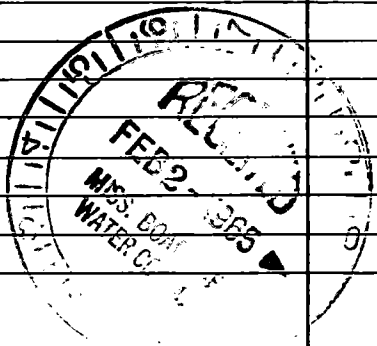

(Use Back Side)

Well No.

100

Handwritten notes in the upper left quadrant, including the word "Lecture" and other illegible scribbles.

Handwritten notes in the upper right quadrant, including the word "Lecture" and other illegible scribbles.

Handwritten notes in the middle right section, including the word "Lecture" and other illegible scribbles.

Handwritten notes in the lower right section, including the word "Lecture" and other illegible scribbles.

Handwritten notes in the lower middle section, including the word "Lecture" and other illegible scribbles.

Handwritten notes in the lower right section, including the word "Lecture" and other illegible scribbles.