

E 26

12-30-64 WATER WELL DRILLERS LOG

Date: Dec. 30, 1964, Driller: Joe Miller County Harrison
(Name)

(1) Owner of Land: Jimmy Franko
(Name)
R.R. #1 Perrytown
(Address)

(2) Location: 1/4, 1/4, Sec. T. R.
12 miles West of Lyman
(distance) (direction) (nearest Town)

(3) Topography: Hilly
(Hilly) (Flat) (Level)

(4) Purpose of Well: Domestic
(Domestic Irrigation Municipal, Industrial, Other)

Description & Color of Materials Sand, Clay, Red Clay, Shell, etc.	Thick- ness Feet	Depth Feet
Surface	5	5
Red Clay	35	40
Red sand, coarse	32	72
Red Clay White Clay	34	106
White Clay	29	135
Hard Blue Clay	217	352
Soft	37	389
Hard + Gummy Blue Clay	63	452
Gray sand (fine)	74	526
" " Yellow Pebbles		537
" " Fine		545
Hard Blue Clay		548

Information upon completion of well:

(1) Diameter 2 inches.

(2) Total Depth 548' feet.

(3) Water Level 117' feet below top of ground.

(4) Cased to 535', Size 2"


(5) Screen: Size 2", Length 10'

(6) Were any formations sealed against pollution?
 yes, no.

If YES depth of formation

Why

Drillers Remarks:

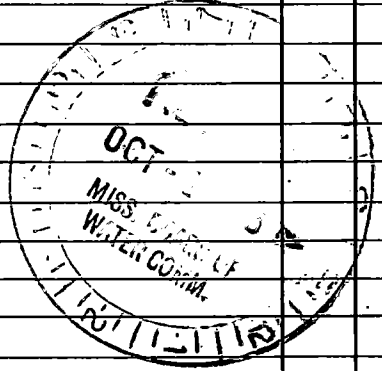

(Use Back Side)

Well No.

S

49 Hwy

Lipman

53 Hwy

12 mi

W

Wagon
River

E

N

