

HARRISON  
E 27  
6-16-71

MISSISSIPPI  
 BOARD OF WATER COMMISSIONERS  
 416 North State Street  
 Jackson, Mississippi 39201

**CODED**

WATER WELL DRILLERS LOG

June 16 1971 Ladmiss Well Works Harrison  
 date well completed firm name county well located

LANDOWNER: Julia Elam  
Lizana, Miss.

description of formations encountered	from	to
<u>yellow clay</u>	<u>0</u>	<u>60</u>
<u>Blue clay</u>	<u>60</u>	<u>125</u>
<u>Blue sand</u>	<u>125</u>	<u>265</u>

(mailing address)

WELL LOCATION:

sec. 12 T. 6 N. R. 13 E.  
1/2 miles 3 of Lizana  
 (distance) (direction) (nearest town)

WELL PURPOSE: home  
 (home, irrigation, municipal, industrial)

WELL COMPLETION DATA:

- (1) diameter (inches) 2 inch  
 (2) total depth (feet) 275  
 (3) static water level (feet) 50 <sup>below</sup> above top of ground.  
 (4) casing Gal. 265  
 (material) (depth)

2 in. If telescope see back.  
 (size)

- (5) screen 10 ft. 265 ft.  
 (length) (depth to top)

2 in. SS.  
 (size) (material)

- (6) pump 1 6 gal.  
 (HP) (yield/gpm)

Elec.  
 (type power)

- (7) electric log no  
 (yes or no)

(organization running log)

- (8) how well bottom plugged Ball Check

DRILLERS REMARKS:


**CODED**

JUL 21 1971

MISS. BO. OF  
 WATER COM.

If well telescopes please sketch and show depths.

GROUND LEVEL

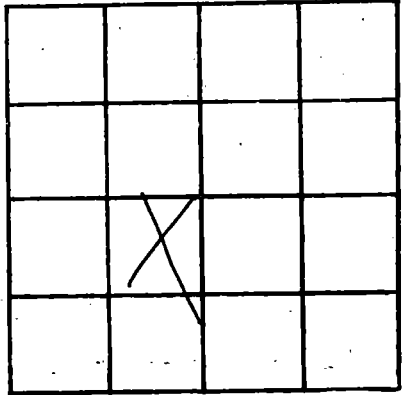

SECTION 12

Please indicate well location X.

ADDITIONAL INFORMATION

If more than one screen, show locations of each on sketch.