

Harrison  
E 31  
8-66

MISSISSIPPI BOARD OF WATER COMMISSIONERS

**CODED**

**WATER WELL DRILLERS LOG**

Date: 8-4, 1966, Driller: HATTIEBURG- BUTANE County HARRISON

(Name)

(1) Owner of Land: Bervell Cuevas  
(Name)  
Rt 1 BOX 46 Saver, Miss  
(Address)  
(2) Location: SE 1/4, SE 1/4, Sec. 24 T5 R12  
6 13  
3 miles SSSE of Lizama  
(distance) (direction) (Nearest Town)  
(3) Topography: level  
(Hilly) (Flat) (Level)  
(4) Purpose of Well: Domestic  
(Domestic Irrigation  
Municipal, Industrial, Other)


Description & Color of Materials Sand, Clay, Red Clay, Shell, etc.	Thick- ness Feet	Depth Feet
<u>red clay</u>	<u>0</u>	<u>17</u>
<u>yellow sand</u>	<u>17</u>	<u>22</u>
<u>white sand</u>	<u>22</u>	<u>67</u>
<u>white clay</u>	<u>67</u>	<u>118</u>
<u>blue sand</u>	<u>118</u>	<u>140</u>
<u>white clay</u>	<u>140</u>	<u>169</u>
<u>blue sand</u>	<u>169</u>	<u>230</u>

Information upon completion of well:

(1) Diameter 2 inches.  
(2) Total Depth 230 feet.  
(3) Water Level 59 feet below top of ground.  
(4) Cased to 220', Size 2"  
(5) Screen: Size 2", Length 10'  
(6) Were any formations sealed against pollution?  
no

**CODED**

If YES depth of formation \_\_\_\_\_  
Why \_\_\_\_\_  
Drillers Remarks: \_\_\_\_\_

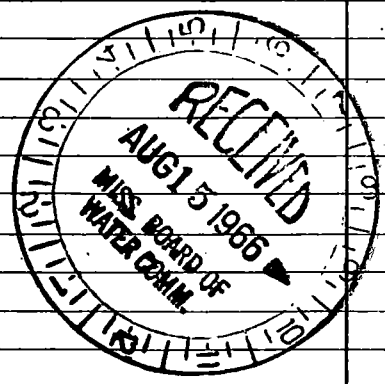

(Use Back Side)

Well No.

