

Harrison
E 32
12-66

MISSISSIPPI
BOARD OF WATER COMMISSIONERS
416 North State Street
Jackson, Mississippi 39201

CODED

WATER WELL DRILLERS LOG

12-16-66 date well completed SUTTER WELL WORKS firm name HARRISON county well located

LANDOWNER: EULIS CUEVAS

description of formations encountered	from	to
SAND	0	18
RED SAND	18	70
WHITE CLAY	70	91
SAND	91	159
CLAY, SAND STREAKS	159	520
SAND	520	624

RT. 2 Box 186

GULFPORT, Miss.
(mailing address)

WELL LOCATION:


sec. 13 T. 6 S. R. 13 E. W.
1 miles S of LIZANA
(distance) (direction) (nearest town)

WELL PURPOSE: Home
(home, irrigation, municipal, industrial)

WELL COMPLETION DATA:

- (1) diameter (inches) 2
- (2) total depth (feet) 624
- (3) static water level (feet) 110 below top of ground.
- (4) casing GALV. (609')
(material) (depth)
2" If telescope see back.
(size)
- (5) screen 15' (609')
(length) (depth to top)
2" (S.S.)
(size) (material)
- (6) pump UNKNOWN (HP) (yield gpm)
(type power)
- (7) electric log No (yes or no)
(organization running log)
- (8) how well bottom plugged B.P. VALVE

CODED

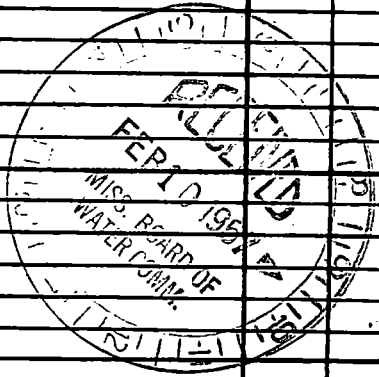

DRILLERS REMARKS:

If well telescopes please sketch and show depths.

GROUND LEVEL



X			

SECTION 13

Please indicate well location X.

ADDITIONAL INFORMATION

If more than one screen, show locations of each on sketch.