

Harrison
E 33
3-67

MISSISSIPPI
BOARD OF WATER COMMISSIONERS
416 North State Street
Jackson, Mississippi 39201

CODED

WATER WELL DRILLERS LOG

March 24 1967 M+B Drilling Co. Harrison
date well completed firm name county well located

LANDOWNER: J.S. Faggio

Rt. 1

Saucier, Miss.
(mailing address)

WELL LOCATION:

sec 2 T 6 S R 13 W
1 miles NW of Ozona
(distance) (direction) (nearest town)

WELL PURPOSE: Farm Home
(home, irrigation, municipal, industrial)

WELL COMPLETION DATA:

- (1) diameter (inches) 4 X 2
- (2) total depth (feet) 332
- (3) static water level (feet) 130 below top of ground
- (4) casing Galv Steel 322 (material) (depth)

(size) if telescope see back.

- (5) screen 10 FT 322 (length) (depth to top)

2" Galv Brass (size) (material)

- (6) pump 1 4 (HP) (yield gpm)

10 220V AC (type power)

- (7) electric log No (yes or no)

(organization running log)


- (8) how well bottom plugged Back Wash Valve

description of formations encountered

from to

Sandy Clay	0	15
Med Sand & Clay	15	75
Sand & Gravel & Red Silt	75	110
Gravel	110	135
Coarse Sand & Med Clay Silt	135	225
Heavy Coarse Sand	225	236
Yellow Clay	236	246
White Clay	246	260
Brown Sand	260	265
Yellow Clay	265	274
Blue Clay	274	280
Fine Sand	280	285
Medium Sand	285	290
Black Muck, Sand, Bark, leaves	290	298
Blue Clay	298	313
Good Sand	313	332
Blue Clay		

CODED

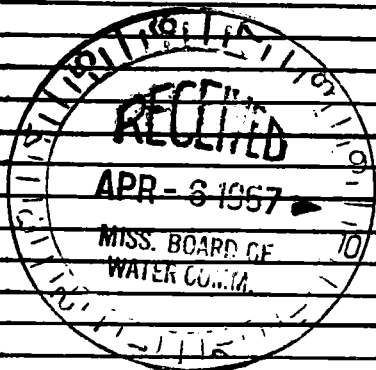


DRILLERS REMARKS:

If well telescopes please sketch and show depths.

GROUND LEVEL

bottom of flow y.

of well

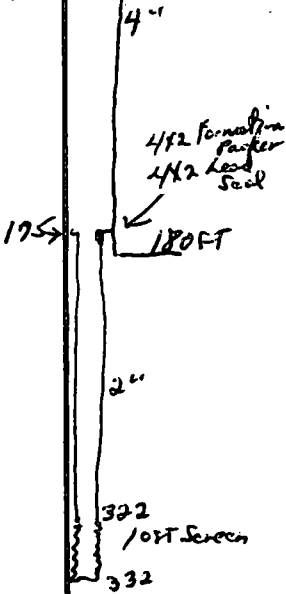

			X

SECTION 2

Please indicate well location X.

ADDITIONAL INFORMATION

If more than one screen, show locations of each on sketch.