

Harrison  
E 34  
4-67

MISSISSIPPI  
BOARD OF WATER COMMISSIONERS  
416 North State Street  
Jackson, Mississippi 39201

**CODED**

WATER WELL DRILLERS LOG

4-20 1967 Sutter Well Works Harrison  
date well completed firm name county well located

LANDOWNER: Reno Cuevas

description of formations encountered

from

to

Rt. 2 Box 281

Gulfport Miss  
(mailing address)

Clay  
Sand - Red  
Clay  
Sand

0 18  
18 68  
68 178  
178 215

WELL LOCATION:

sec. 26 T. 6 S. R. 13 E.  
2 miles S of Bogalusa  
(distance) (direction) (nearest town)

WELL PURPOSE: home  
(home, irrigation, municipal, industrial)

WELL COMPLETION DATA:

(1) diameter (inches) 2  
(2) total depth (feet) 215  
(3) static water level (feet) 67 below  
top of ground.

(4) casing galv., 210'  
(material) (depth)

(size) If telescope see back.

(5) screen 5', 210'  
(length) (depth to top)

2", stainless steel  
(size) (material)

(6) pump 1/2, 10  
(HP) (yield gpm)

elec.  
(type power)


(7) electric log no  
(yes or no)

(organization running log)

(8) how well bottom plugged B.P. Valve

DRILLERS REMARKS:

**CODED**

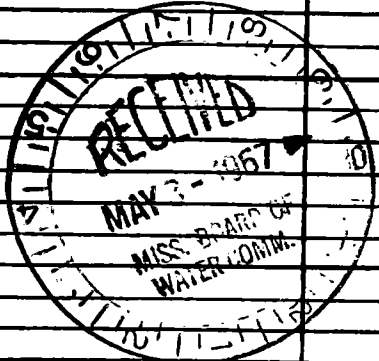

If well telescopes please sketch and show depths.

GROUND LEVEL

A 4x4 grid diagram. The top-right cell contains an 'X'. To the left of the grid is an upward-pointing arrow with the number '2' written below it.

SECTION 26

Please indicate well location X.

ADDITIONAL INFORMATION

Multiple horizontal lines for writing additional information.

If more than one screen, show locations of each on sketch.