

Harrison
E 36
12-67

MISSISSIPPI
BOARD OF WATER COMMISSIONERS
416 North State Street
Jackson, Mississippi 39201

CODED

WATER WELL DRILLERS LOG

12-1 1967 date well completed
Lutter Well Works firm name
Harrison county well located

LANDOWNER: W.E. NIPLET
Rt. 1 Box 98
Jaucien Miss.
(mailing address)

description of formations encountered	from	to
Clay	0	25
sand	25	96
Clay	96	155
Clay & sand str.	155	210
sand	210	260
Clay	260	280
sand	280	306


WELL LOCATION:
sec. 12 T. 6 N. R. 13 W.
S. of Lujana
(distance) (direction) (nearest town)

WELL PURPOSE: home
(home, irrigation, municipal, industrial)

WELL COMPLETION DATA:

- (1) diameter (inches) 2
- (2) total depth (feet) 306
- (3) static water level (feet) 132 below
top of ground.
- (4) casing galv., 296'
(material) (depth)
2" if telescope see back.
(size)
- (5) screen 10', 296'
(length) (depth to top)
2", stainless steel
(size) (material)
- (6) pump 1 1/2 10
(HP) (yield gpm)
elec
(type power)
- (7) electric log no
(yes or no)
(organization running log)
- (8) how well bottom plugged B.P. Value

CODED

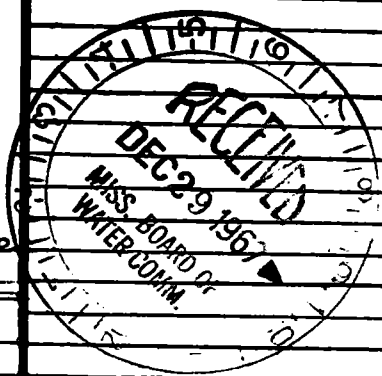

DRILLERS REMARKS:

If well telescopes please sketch and show depths.

GROUND LEVEL

10 0
10 20
10 40
10 60
10 80
10 100
10 120
10 140
10 160
10 180

10 20
10 40
10 60
10 80
10 100
10 120
10 140
10 160
10 180



		X	

SECTION 12

Please indicate well location X.

ADDITIONAL INFORMATION

If more than one screen, show locations of each on sketch.