

Harrison
E 38
6-21-68

MISSISSIPPI
 BOARD OF WATER COMMISSIONERS
 416 North State Street
 Jackson, Mississippi 39201

CODED

WATER WELL DRILLERS LOG

6-21 1968 Sutter Well Works Harrison
 date well completed firm name county well located

LANDOWNER Lavender Cuevas
Luzma, Miss.

description of formations encountered	from	to
<u>Sand</u>	<u>0</u>	<u>198</u>
<u>Clay</u>	<u>198</u>	<u>280</u>
<u>Sand</u>	<u>280</u>	<u>304</u>

(mailing address)

WELL LOCATION:
 sec. 12 T. 6 N. R. 13 E
1/2 miles S of Luzma
 (distance) (direction) (nearest town)

WELL PURPOSE: home
 (home, irrigation, municipal, industrial)


WELL COMPLETION DATA:

- (1) diameter (inches) 2
- (2) total depth (feet) 304
- (3) static water level (feet) 50 below top of ground.
- (4) casing galv. 294'
 (material) (depth)
- 2"
 (size) if telescope see back.
- (5) screen 10' 294'
 (length) (depth to top)
- 5" Stainless steel
 (size) (material)
- (6) pump unknown
 (HP) (yield gpm)

CODED

- (type power)
- (7) electric log no
 (yes or no)
- (organization running log)
- (8) how well bottom plugged BPU valve

DRILLERS REMARKS:

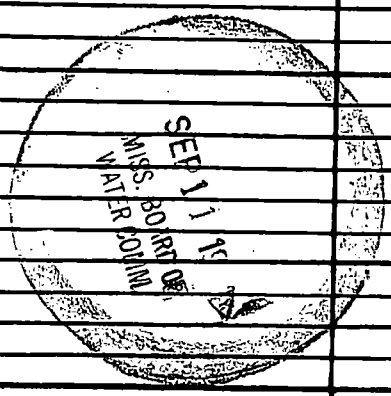

If well telescopes please sketch and show depths.

GROUND LEVEL

X			

SECTION 12

Please indicate well location X.

ADDITIONAL INFORMATION

If more than one screen, show locations of each on sketch.