

Janusir
 E 40
 3-68

MISSISSIPPI
 BOARD OF WATER COMMISSIONERS
 416 North State Street
 Jackson, Mississippi 39201

CODED

WATER WELL DRILLERS LOG

March 28 1968 Palmer's Well Works Harrison
 date well completed firm name county well located

LANDOWNER: Sam Curran

description of formations encountered	from	to

Standard

<u>Red Sandy Clay</u>	<u>0</u>	<u>90</u>
<u>Light Blue Sand</u>	<u>90</u>	<u>110</u>

(mailing address)

WELL LOCATION:

sec. 11 T. 6 N. R. 13 E.
3 miles South Standard
 (distance) (direction) (nearest town)

CODED CODED

WELL PURPOSE: Home
 (home, irrigation, municipal, industrial)

WELL COMPLETION DATA:

- (1) diameter (inches) 2 inch
- (2) total depth (feet) 110
- (3) static water level (feet) 40 ^{below}/_{above} top of ground.
- (4) casing 2 inch 107
 (material) (depth)
2 inch if telescope see back.
 (size)
- (5) screen 10 100
 (length) (depth to top)
008 Stainless Steel
 (size) (material)
- (6) pump 1 20
 (HP) (yield gpm)
Elec
 (type power)
- (7) electric log No
 (yes or no)

CODED
 CODED
(organization running log)


(8) how well bottom plugged Back
Wash Valve

DRILLERS REMARKS:



If well telescopes please sketch and show depths.

GROUND LEVEL

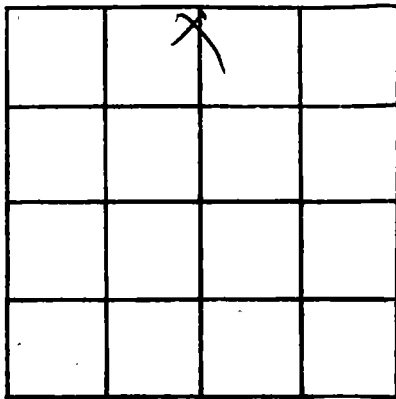

SECTION 4

Please indicate well location X.

ADDITIONAL INFORMATION

If more than one screen, show locations of each on sketch.