

CODED

Harrison
E4
11-14-68

MISSISSIPPI
BOARD OF WATER COMMISSIONERS
416 North State Street
Jackson, Mississippi 39201

CODED

WATER WELL DRILLERS LOG

Nov. 14 1968 M&B Drilling Co. Harrison
date well completed firm name county well located

LANDOWNER: Charles Lizana
R.R. Lizana
Gulfport, Miss
(mailing address)

WELL LOCATION:
sec. 12 T 6 S R 13 W
1 miles W of Lizana
(distance) (direction) (nearest town)

WELL PURPOSE: Home
(home, irrigation, municipal, industrial)

- WELL COMPLETION DATA:
- (1) diameter (inches) 2"
 - (2) total depth (feet) 670
 - (3) static water level (feet) 102 below top of ground
 - (4) casing Steel 610 (material), (depth)
2" If telescope see back. (size)
 - (5) screen 10ft 610 (length), (depth to top)
2" S.S. - .0105/ft (size), (material)
 - (6) pump 1-2 1/2 hp 6 (HP), (yield gpm)
220 V 1φ (type power)
 - (7) electric log No. (yes or no)
(organization running log)
 - (8) how well bottom plugged 2" B.Gosh Valve

| description of formations encountered | from | to |
|---------------------------------------|------|-----|
| Surface Clay | 0 | 15 |
| Red Sandy Clay | 15 | 50 |
| White Clay | 50 | 75 |
| Sand | 75 | 117 |
| White Clay | 117 | 165 |
| Fine Sand Clay Breaks | 165 | 175 |
| Soft Gray Clay | 175 | 200 |
| " Blue Clay | 200 | 250 |
| Hard Blue Clay | 250 | 365 |
| Fine Sand Clay Breaks | 365 | 325 |
| Blue Clay, Red clay | | |
| White Clay - Hard | 325 | 530 |
| Sand | 530 | 628 |
| Still Cutting Sand | | |

Circulation Low 300 365

Pumped out 7 Yds of cuttings
from 300 - 475 FT
This from a 4 1/2" hole

J. B. Borden

CODED


DEC 10 1968

MISS. BD. OF
WATER COMMISSIONERS

DRILLERS REMARKS:

If well telescopes please sketch and show depths.

GROUND LEVEL

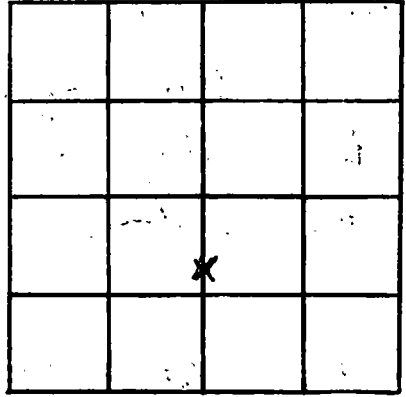

SECTION 6

Please indicate well location X.

ADDITIONAL INFORMATION

If more than one screen, show locations of each on sketch.