

Harrison  
E 42  
12-28-69

MISSISSIPPI  
BOARD OF WATER COMMISSIONERS  
416 North State Street  
Jackson, Mississippi 39201

**CODED**

WATER WELL DRILLERS LOG

Dec. 28 1969 Ladonia Well Works Harrison  
date well completed firm name county well located

LANDOWNER: Robert Lizina  
Lizina, Miss  
(mailing address)

description of formations encountered	from	to
<u>yellow clay</u>	<u>60 feet</u>	
<u>yellow sand</u>	<u>5 feet</u>	
<u>Blue clay</u>	<u>200 feet</u>	
<u>Blue sand</u>	<u>31 feet</u>	

WELL LOCATION:  
sec. 1 T. 6 N R. 13 W  
S W  
\_\_\_\_\_ miles \_\_\_\_\_ of Lizina  
(distance) (direction) (nearest town)

WELL PURPOSE: Home  
(home, irrigation, municipal, industrial)

- WELL COMPLETION DATA:
- (1) diameter (inches) 2 inch
  - (2) total depth (feet) 296
  - (3) static water level (feet) 60 below top of ground.
  - (4) casing gal. 286  
(material) (depth)  
2 inch if telescope see back.  
(size)
  - (5) screen 10 286  
(length) (depth to top)  
2 inch, Stainless Steel  
(size) (material)
  - (6) pump 1/2 8  
(HP) (yield gpm)  
Electric  
(type power)
  - (7) electric log no  
(yes or no)
- \_\_\_\_\_  
(organization running log)

**CODED**

MAR 6 1969


(8) how well bottom plugged Ball Check

MISS. BD. OF  
WATER COMM.

DRILLERS REMARKS:

If well telescopes please  
sketch and show depths.

GROUND LEVEL

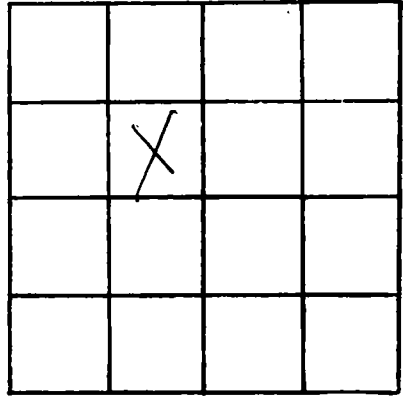

SECTION 1

Please indicate well location X.

ADDITIONAL INFORMATION

If more than one screen,  
show locations of each on sketch.