

MISSISSIPPI
BOARD OF WATER COMMISSIONERS
416 North State Street
Jackson, Mississippi 39201

CODED

WATER WELL DRILLERS LOG

Harrison
E 43
R 3169

date well completed Jan. 31 1969 firm name Ladnier Well Works county well located Harrison

LANDOWNER: <u>B Arney</u> <u>Cuenas</u>	description of formations encountered	from	to
<u>Standard</u> (mailing address)	<u>Yellow clay</u>	<u>20 feet</u>	
WELL LOCATION: sec. <u>13</u> T <u>6</u> N R <u>13</u> W <u>3</u> miles <u>North</u> of <u>W 13</u> (distance) (direction) (nearest town)	<u>White sand</u> <u>And gravel</u>	<u>40 feet</u>	
WELL PURPOSE: <u>home</u> (home, irrigation, municipal, industrial)	<u>Yellow clay</u>	<u>40 feet</u>	
WELL COMPLETION DATA:	<u>Blue clay</u>	<u>200 feet</u>	
(1) diameter (inches) <u>2 inch</u>	<u>Blue sand</u>	<u>24 feet</u>	
(2) total depth (feet) <u>326</u>			
(3) static water level (feet) <u>40</u> below top of ground.			
(4) casing <u>gal.</u> <u>316</u> (material) (depth)			
<u>2 inch</u> if telescope see back. (size)			
(5) screen <u>10</u> <u>316</u> (length) (depth to top)			
<u>2 inch</u> <u>Stainless steel</u> (size) (material)			
(6) pump <u>1 hp</u> <u>8</u> (HP) (yield gpm)			
<u>Electric</u> (type power)			
(7) electric log <u>no</u> (yes or no)			
(organization running log)			
(8) how well bottom plugged <u>Ball check</u>			
DRILLERS REMARKS:			


CODED

MAR 6 1969

If well telescopes please sketch and show depths.

or

GROUND LEVEL

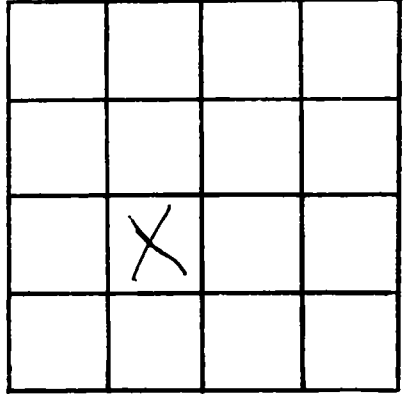

SECTION 13

Please indicate well location X.

ADDITIONAL INFORMATION

If more than one screen, show locations of each on sketch.