

CODED

MISSISSIPPI  
BOARD OF WATER COMMISSIONERS  
416 North State Street  
Jackson, Mississippi 39201

WATER WELL DRILLERS LOG

Harrison  
E48  
7-11-69

7/11/69 date well completed  
19 Coastal Drilling firm name  
Harrison county well located

LANDOWNER Mr. Moughlin

description of formations encountered

from to

Shaw  
Rt 3 Apt. Miss.  
(mailing address)

Top Soil 1 5  
Red Clay 5 15  
Sand & gravel 15 45  
Blue Clay 45 166  
Coarse Sand 166 199  
well to drill

WELL LOCATION:

25 T 6 N R 13  
6 miles N of Apt  
(distance) (direction) (nearest town)

WELL PURPOSE: home  
(home, irrigation, municipal, industrial)

WELL COMPLETION DATA:

- (1) diameter (inches) 2"
- (2) total depth (feet) 199'
- (3) static water level (feet) \_\_\_\_\_ below above top of ground
- (4) casing 2" 199'  
(material) (depth)

(size) if telescope see back.

- (5) screen 10' 2 2  
(length) (depth to top)  
(size) (material)

- (6) pump 1 Pp 17  
(HP) (yield gpm)  
etc  
(type power)

- (7) electric log (yes or no) \_\_\_\_\_

(organization running log)

- (8) how well bottom plugged good

DRILLERS REMARKS:


None

OCT 31 1969

MISS. BD. OF  
WATER COMM

If well telescopes please sketch and show depths.

GROUND LEVEL

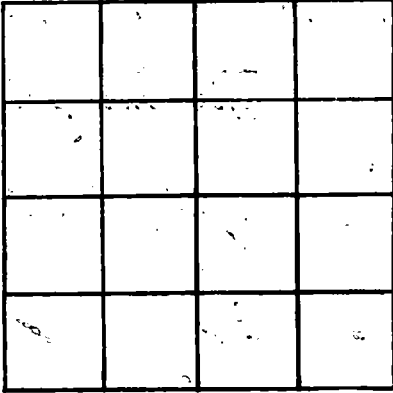

SECTION 25

Please indicate well location X.

ADDITIONAL INFORMATION

Lined area for additional information.

If more than one screen, show locations of each on sketch.