

Harrison Co
E 51
10-69

MISSISSIPPI
BOARD OF WATER COMMISSIONERS
416 North State Street
Jackson, Mississippi 39201

CODED

WATER WELL DRILLERS LOG

October 20 1969 Adair's Well Works Harrison
date well completed firm name county well located

LANDOWNER: Haven
Lizana
Lizana, Miss.
(mailing address)
WELL LOCATION:
sec. 4 T. 6 N. R. 13 E
S W
8 miles West of Syman
(distance) (direction) (nearest town)

description of formations encountered	from	to
Red Clay	30	ft
Red Sand	20	ft
Red & Yellow Clay	75	ft
Light Blue Clay	20	ft
Light Blue Sand	30	ft

WELL PURPOSE: Home
(home, irrigation, municipal, industrial)

WELL COMPLETION DATA:
(1) diameter (inches) 2 inch
(2) total depth (feet) 175 ft.
(3) static water level (feet) 60 below above top of ground.
(4) casing gal., 170
(material) (depth)
2 inch If telescope see back.
(size)
(5) screen 5 ft., 170 ft.
(length) (depth to top)
2 inch, Stainless Steel
(size) (material)
(6) pump 1 6 gal.
(HP) (yield gpm)
Electric
(type power)
(7) electric log NO
(yes or no)
(organization running log)

(8) how well bottom plugged
Ball Check


DRILLERS REMARKS:

FEB 4 1970

MISS. BD. OF
WATER COM.

If well telescopes please sketch and show depths.

GROUND LEVEL

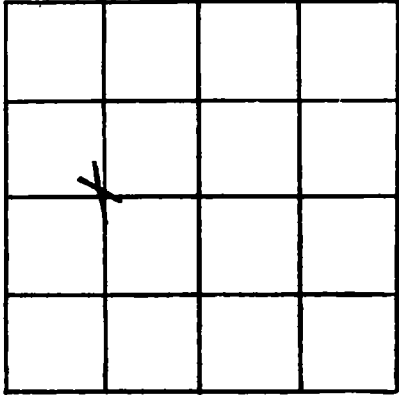

SECTION 4

Please indicate well location X.

ADDITIONAL INFORMATION

If more than one screen, show locations of each on sketch.