

Harrison Co
E 52
12-69

MISSISSIPPI
BOARD OF WATER COMMISSIONERS
416 North State Street
Jackson, Mississippi 39201

COPIED

WATER WELL DRILLERS LOG

Dec. 29 1969 Ladner's Well Works Harrison
date well completed firm name county well located

LANDOWNER: Harold Lacy
Hull Haven Road
Syman, Miss.
(mailing address)

description of formations encountered	from	to
Red & Yellow Clay	60	ft
Yellow Sand	20	ft
Blue Clay	300	ft
Coarse Blue Sand	40	ft

WELL LOCATION:
sec. 7 T. 6 N. R. 13 E
S W
4 1/2 miles West of Syman
(distance) (direction) (nearest town)

WELL PURPOSE: Home
(home, irrigation, municipal, industrial)

WELL COMPLETION DATA:

- (1) diameter (inches) 2 inch
- (2) total depth (feet) 420 ft.
- (3) static water level (feet) 60 below above top of ground.
- (4) casing gal. 405 ft.
(material) (depth)
2 inch If telescope see back.
(size)
- (5) screen 15 ft. 405 ft.
(length) (depth to top)
2 inch Stainless Steel
(size) (material)
- (6) pump 1 9
(HP) (yield gpm)
Electric
(type power)
- (7) electric log No
(yes or no)

(organization running log)

(8) how well bottom plugged Ball Plug


DRILLERS REMARKS:

FEB 4 - 1970

MISS. BD. OF
WATER COMM.

If well telescopes please sketch and show depths.

GROUND LEVEL

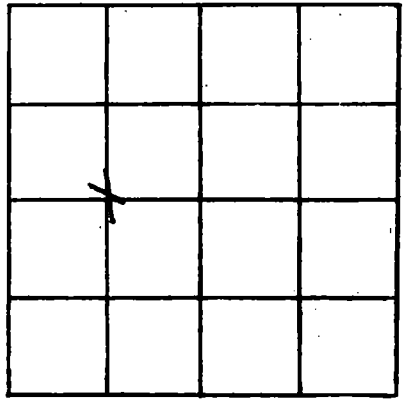

SECTION 4

Please indicate well location X.

ADDITIONAL INFORMATION

If more than one screen, show locations of each on sketch.