

Harrison
E 54
2-16-70

MISSISSIPPI
BOARD OF WATER COMMISSIONERS
416 North State Street
Jackson, Mississippi 39201

CODED

WATER WELL DRILLERS LOG

2-16-70 19 R. J. Moore HARRISON
date well completed firm name county well located

LANDOWNER: Abraham Milton

description of formations encountered

from to

RT #2 Box 223

GOLSPORT MISS
(mailing address)

SURFACE SOIL	0	18
White Sand	10	30
White & Blue Clay	30	104
Blue Sand	104	135

WELL LOCATION:

sec. 23 T. 6 N. R. 13 E
18 miles NW of GOLSPORT
(distance) (direction) (nearest town)

WELL PURPOSE: Home
(home, irrigation, municipal, industrial)

WELL COMPLETION DATA:

- (1) diameter (inches) 2"
- (2) total depth (feet) 136'
- (3) static water level (feet) 55' (below/above top of ground)
- (4) casing galv, 126'
(material) (depth)
2" If telescope see back.
(size)
- (5) screen 2x10, 126'
(length) (depth to top)
2, 95
(size) (material)
- (6) pump 1, 640 HR
(HP) (yield gpm)
Flow
(type power)
- (7) electric log _____
(yes or no)

(organization running log)
- (8) how well bottom plugged BW
galv

CODED


MAR 4 - 1970

DRILLERS REMARKS:

MISS. BD. OF
WATER COMM.

If well telescopes please sketch and show depths.

GROUND LEVEL

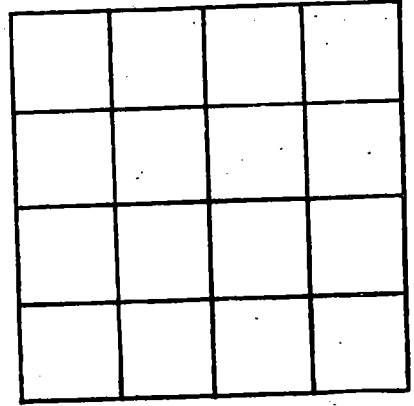

SECTION _____

Please indicate well location X.

ADDITIONAL INFORMATION

If more than one screen, show locations of each on sketch.