

HARRISON

E 59

12-2-70

MISSISSIPPI
 BOARD OF WATER COMMISSIONERS
 416 North State Street
 Jackson, Mississippi 39201

CODED

WATER WELL DRILLERS LOG

12/2/70 date well completed
 Central Valley Co. firm name
 Harrison county well located

LANDOWNER: A.W. Allen

1220 20th Ave

Shulps Miss
 (mailing address)

WELL LOCATION:

sec. 7 T 6 N R 13 E
 S W
 5 miles (distance) Niball, Miss. (direction) (nearest town)

WELL PURPOSE:
 (home, irrigation, municipal, industrial)

WELL COMPLETION DATA:

- (1) diameter (inches) 2"
- (2) total depth (feet) 340
- (3) static water level (feet) 16' below top of ground
- (4) casing glass (material), 330 (depth)
- (size) If telescope see back.
- (5) screen 10' (length), 330 (depth to top)
- 2" (size), SS (material)
- (6) pump 1 HP (HP), 19 (yield gpm)
- Elc (type power)
- (7) electric log no (yes or no)

(organization running log)
 (8) how well bottom plugged 2' back wash valve

description of formations encountered	from	to
Top Soil	1	7
Red Clay	7	13
glaucon	13	34
Silt	34	67
fine water sand	67	120
Soft Blue Clay	120	235
fine water sand	235	270
hard blue clay	270	286
Rock	286	290
fine water sand	290	322
Coarse water sand	322	340

CODED

JAN 13 1971

DRILLERS REMARKS:


None

MISS. BD. OF WATER COMM.

If well telescopes please sketch and show depths.

1300

GROUND LEVEL

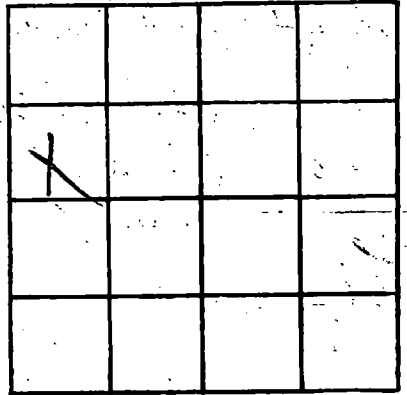

SECTION _____

Please indicate well location X.

ADDITIONAL INFORMATION

If more than one screen, show locations of each on sketch.