

HAR.
E62
7-5-65

MISSISSIPPI BOARD OF WATER COMMISSIONERS

M524310

WATER WELL DRILLERS LOG

CODED

Date: July 5, 1965, Driller: Joe Miller County: Harrison
(Name)

(1) Owner of Land: Fred Lizano
(Name)
RR # Gulfport.
(Address)

(2) Location: 1/4, 1/4, Sec. 12 T 6 R 13
10 miles W of Lymon
(distance) (direction) (Nearest Town)

(3) Topography: Hilly
(Hilly) (Flat) (Level)

(4) Purpose of Well: Domestic
(Domestic Irrigation
Municipal, Industrial, Other)

Description & Color of Materials Sand, Clay, Red Clay, Shell, etc.	Thick- ness Feet	Depth Feet
Surface	12	12
Red Sand	23	35
Red Clay	10	45
Sand & Gravel	17	62
White Clay	48	110
Blue Clay	10	120
White Clay	59	179
Tan Sand (Fine Sd)	11	190
" " "	10	200
" " (Fair)	11	211
" " Good	10	221
" " "	2	223
'Red Clay'	2	225

Information upon completion of well:

(1) Diameter 2" inches.

(2) Total Depth 225' feet.

(3) Water Level 61' feet below top of ground.

(4) Cased to 210', Size 2"

(5) Screen: Size 2", Length 10'


(6) Were any formations sealed against pollution?
_____ yes, _____ no.

If YES depth of formation _____

Why _____

Drillers Remarks: _____

5' Tail Pipe

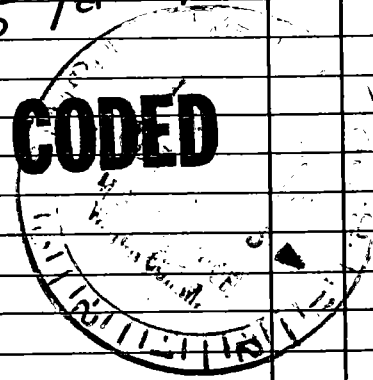

(Use Back Side)

Well No.

Gulfport
Miss

S

HKy 49

E

HKy 53

10 mi

Tower
Sharp
Patrol

W

N

