

HARRISON
E64
8-27-71

MISSISSIPPI
 BOARD OF WATER COMMISSIONERS
 416 North State Street
 Jackson, Mississippi 39201

FEB 14 1972

WATER WELL DRILLERS LOG

CLASS. NO. OF

Aug 27 19 71 Mc Gil well works Harrison
 date well completed firm name county well located

LANDOWNER: Douglas Moran
RE. 2, Box 209
Hef. Ms.
 (mailing address)

description of formations encountered	from	to
Clay	0	30
Sand	35	110
Blue CODED	110	178
Sand	178	200

WELL LOCATION:
 sec. 11 T. 6 N R. 13 E
5 miles SW of Stamps
 (distance) (direction) (nearest town)

WELL PURPOSE: Municipal
 (home, irrigation, municipal, industrial)


- WELL COMPLETION DATA:
- (1) diameter (inches) 200 1/2"
 - (2) total depth (feet) 200
 - (3) static water level (feet) 41' below top of ground
 - (4) casing gal. 190'
 (material) (depth)
 (size) if telescope see back.
 - (5) screen 10' 10'
 (length) (depth to top)
2" S.S.
 (size) (material)
 - (6) pump 1 60
 (HP) (yield gpm)
electric
 (type power)
 - (7) electric log no
 (yes or no)
 - (organization running log)
 - (8) how well bottom plugged closed
work

CODED

DRILLERS REMARKS:

If well telescopes please sketch and show depths.

GROUND LEVEL

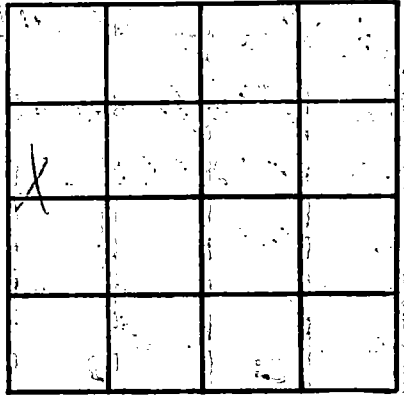

SECTION 11

Please indicate well location X.

ADDITIONAL INFORMATION.

If more than one screen, show locations of each on sketch.