

HARRISON
E 65
1-22-72

MISSISSIPPI
BOARD OF WATER COMMISSIONERS
416 North State Street
Jackson, Mississippi 39201
FEB 14 1972

WATER WELL DRILLERS LOG
MISS. BD. OF
Harrison
McGill Well Works
firm name
1-22-72
date well completed
county well located

LANDOWNER: Elton Ladner
Rt. 2, Box 426
Pass Christian, Miss.
(mailing address)
WELL LOCATION:
sec. 14 T. 6 N R. 13 E
7 miles 5 W of Prichard
(distance) (direction) (nearest town)

WELL PURPOSE: Drill
(home, irrigation, municipal, industrial)

WELL COMPLETION DATA:
(1) diameter (inches) 4 1/2" total
(2) total depth (feet) 430'
(3) static water level (feet) 38' below
top of ground.
(4) casing gal. 430'
(material) (depth)
(size) if telescope see back.
(5) screen 10'
(length) (depth to top)
2" S-S.
(size) (material)
(6) pump 1 6
(HP) (yield gpm)
electric
(type power)
(7) electric log NO
(yes or no)
(organization running log)
(8) how well bottom plugged good
spark

description of formations encountered	from	to
	0	96
	96	218
Sand	218	330
Blue Clay	230	297
Slush	297	378
Blue Clay	378	410
Sand	410	430


CODED

CODED

DRILLERS REMARKS:

If well telescopes please sketch and show depths.

GROUND LEVEL

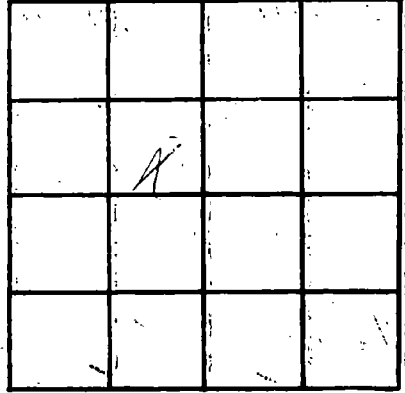

SECTION 14

Please indicate well location X.

ADDITIONAL INFORMATION

If more than one screen, show locations of each on sketch.