

**HARRISON**  
**E 67**  
**6-9-72**

MISSISSIPPI  
 BOARD OF WATER COMMISSIONERS  
 416 North State Street  
 Jackson, Mississippi 39201

**CODED**

**WATER WELL DRILLERS LOG**

June 9 1972 McGill well work Harrison  
 (date well completed) firm name county well located

LANDOWNER: J. L. Saucier  
Rt 1, Box 109  
Saucier, Miss.  
 (mailing address)

description of formations encountered	from	to
clay	0	30
sand	30	187
slush	187	243
clay	243	306
sand	306	349

WELL LOCATION:  
 sec. 12 T. 6 N. R. 13 E  
1 miles S W of Leppan  
 (distance) (direction) (nearest town)

WELL PURPOSE: Home  
 (home, irrigation, municipal, industrial)

WELL COMPLETION DATA:

- (1) diameter (inches) 3 8/2"
- (2) total depth (feet) 211'
- (3) static water level (feet) 38 below above top of ground.
- (4) casing gal. 372'  
 (material) (depth)  
NO (size) if telescope see back.
- (5) screen 2 1/2' 5.5.  
 (length) (depth to top)  
2 1/2" (size) (material)
- (6) pump 1 7  
 (HP) (yield gpm)  
electric (type power)
- (7) electric log NO  
 (yes or no)  
NO (organization running log)
- (8) how well bottom plugged sand  
stark

**CODED**

SEP 5 1972


MISS. BD. OF  
 WATER COMMISSIONERS

DRILLERS REMARKS:

If well telescopes please sketch and show depths.

**03003**

**GROUND LEVEL**

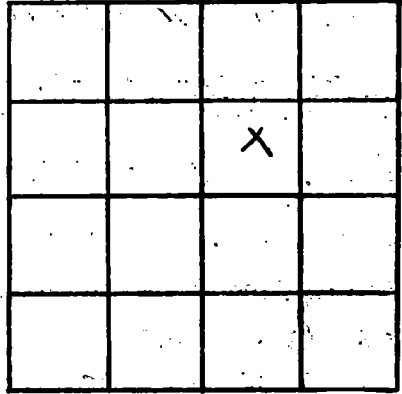

**SECTION** 12

Please indicate well location X.

**ADDITIONAL INFORMATION**

A series of horizontal lines provided for additional information.

**03003**

If more than one screen, show locations of each on sketch.