

HARRISON
E 69
11-2-72

MISSISSIPPI
 BOARD OF WATER COMMISSIONERS
 416 North State Street
 Jackson, Mississippi 39201

WATER WELL DRILLER



November 2 19 72 H.A. Laddie's Well Works HARRISON
 date well completed firm name county well located

LANDOWNER: Mrs. Elem

description of formations encountered

from to

LIZANA, Miss.
 (mailing address)

Red Clay 0 60
Blue Clay 60 550
Blue Sand 550 570

WELL LOCATION:

sec. 4 T. 6 R. 13
5 miles West of Saucier
 (distance) (direction) (nearest town)

WELL PURPOSE: HOME
 (home, irrigation, municipal, industrial)

WELL COMPLETION DATA:

- (1) diameter (inches) 2 inch
- (2) total depth (feet) 600 FT.
- (3) static water level (feet) 85 below above top of ground.
- (4) casing Cas. 570 FT.
 (material) (depth)
- 2 in If telescope see back.
 (size)
- (5) screen 10 ft. 590 ft.
 (length) (depth to top)
- 2 in. S.S.
 (size) (material)
- (6) pump 2 10
 (HP) (yield gpm)
- Elect.
 (type power)
- (7) electric log No
 (yes or no)



(organization running log)

(8) how well bottom plugged Ball Check


NOV 22 1972

DRILLERS REMARKS:

WATER GUARD

If well telescopes please sketch and show depths.

GROUND LEVEL

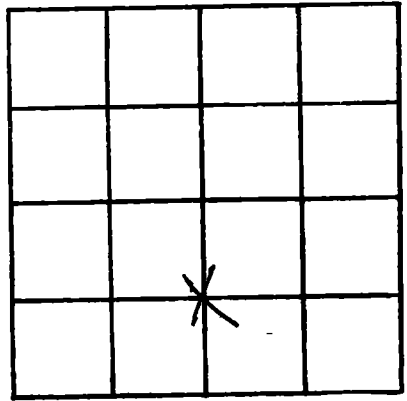

SECTION 4

Please indicate well location X.

ADDITIONAL INFORMATION

If more than one screen, show locations of each on sketch.