

Harrison  
 E 74  
 9-67

MISSISSIPPI  
 BOARD OF WATER COMMISSIONERS  
 416 North State Street  
 Jackson, Mississippi 39201

CODED

WATER WELL DRILLERS LOG

9-20 1967 Hattiesburg Butave HARRISON  
 date well completed firm name county well located

LANDOWNER: Joe Murphy

description of formations encountered

from to

RT. 2

White sand

0 5

Gulfport, Miss.  
 (mailing address)

Yellow clay

6 8

WELL LOCATION:

White sand

9 18

sec. 22 T. 6 R. 13  
 1 1/2 miles SW of LIZANIA  
 (distance) (direction) (nearest town)

Blue clay

19 49

Blue sand

49 69

Blue sand + clay

70 119

Blue sand

120 159

WELL PURPOSE: Home  
 (home, irrigation, municipal, industrial)

WELL COMPLETION DATA:

CODED

(1) diameter (inches) 2"

(2) total depth (feet) 159'

(3) static water level (feet) below above top of ground. FLOWING

(4) casing GALV. pipe 1 1/2" (material) 149' (depth)

2" (size) if telescope see back.

(5) screen 10' (length) 149' (depth to top)

2" (size) STAINLESS STEEL (material)

(6) pump 1 HP ANE 600 (HP) (yield gpm)


electric (type power)

(7) electric log NO (yes or no)

NO (organization running log)


(8) how well bottom plugged BACK WASH VALVE

DRILLERS REMARKS:

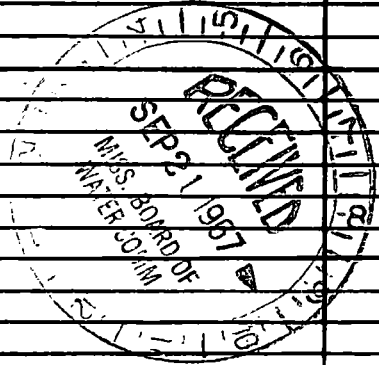

If well telescopes please sketch and show depths.

GROUND LEVEL

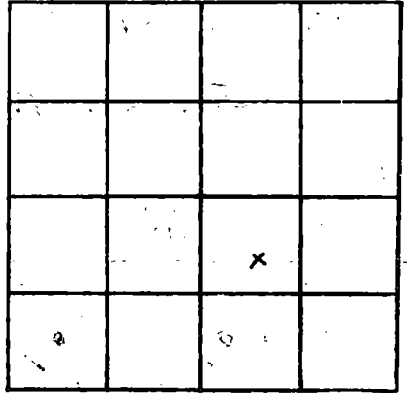

SECTION 22

Please indicate well location X.

ADDITIONAL INFORMATION

Go out Hwy 53 to Lyana  
turn South on Cemetery  
Road - 1/2 mile out of  
road in swamp.

If more than one screen,  
show locations of each on sketch.