

**HARRISON**  
**E 75**  
**1-14-73**

MISSISSIPPI  
 BOARD OF WATER COMMISSIONERS  
 416 North State Street  
 Jackson, Mississippi 39201

**CODED**

**WATER WELL DRILLERS LOG**

JAN. 14 1973 H.A. Ladwice's Well Works HARRISON  
 date well completed firm name county well located

LANDOWNER: MRS. D.P. Keebler  
1526 Olive St.  
Gulfport, Miss.  
 (mailing address)

description of formations encountered	from	to
	yellow clay	0
white sand (grave)	40	80
blue clay	80	240
blue sand	240	280

WELL LOCATION:  
 sec. 4 T. 8 N R. 13 E  
 S W  
0.2 miles south of LIZANA  
 (distance) (direction) (nearest town)

WELL PURPOSE: HOME  
 (home, irrigation, municipal, industrial)

- WELL COMPLETION DATA:
- diameter (inches) 2 inch
  - total depth (feet) 280 FT
  - static water level (feet) 10 below top of ground.
  - casing Galv. 270 FT  
 (material) (depth)  
2 in. if telescope see back.  
 (size)
  - screen 10 FT 270 FT  
 (length) (depth to top)  
2 in. S STEEL  
 (size) (material)
  - pump 1 7  
 (HP) (yield gpm)  
Elect.  
 (type power)
  - electric log NO  
 (yes or no)
- (organization running log)
- (8) how well bottom plugged Ball Check


**CODED**

DRILLERS REMARKS:

**JAN 22 1973**

If well telescopes please sketch and show depths.

GROUND LEVEL

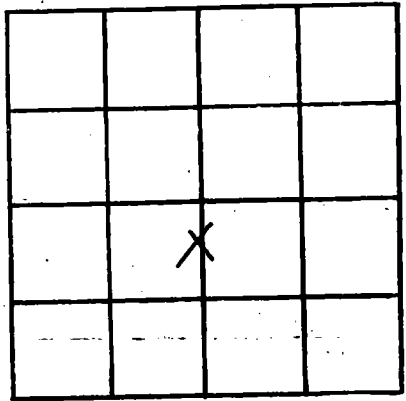

SECTION 4

Please indicate well location X.

**ADDITIONAL INFORMATION**

Lined area for additional information.

If more than one screen, show locations of each on sketch.