

HARRISON
E 77
7-23-73

MISSISSIPPI
BOARD OF WATER COMMISSIONERS
416 North State Street
Jackson, Mississippi 39201

CODED

WATER WELL DRILLERS LOG

Oct 13 1971 Mc Gil well works Harrison
date well completed firm name county well located

LANDOWNER: Beloti, Mo
Oliver Hallamand
Beloti River Estates
(mailing address)

description of formations encountered from to

Sand 0 20

WELL LOCATION:
sec. 26 T. 6 N. R. 13 E
7 miles S.E. of Lymon
(distance) (direction) (nearest town)

WELL PURPOSE: Irrigation
(home, irrigation, municipal, industrial)

- WELL COMPLETION DATA:
- (1) diameter (inches) 1 1/4"
 - (2) total depth (feet) 20'
 - (3) static water level (feet) 2' below above top of ground.
 - (4) casing gal. 10'
(material) (depth)
 - if telescope see back.
(size)
 - (5) screen 10'
(length) (depth to top)
1 1/4" S.S.
(size) (material)
 - (6) pump 1 6
(HP) (yield gpm)
Electric
(type power)
 - (7) electric log NO
(yes or no)
 - (organization running log)
 - (8) how well bottom plugged plug


CODED

DRILLERS REMARKS:

NOV 18 1973

If well telescopes please sketch and show depths.

GROUND LEVEL

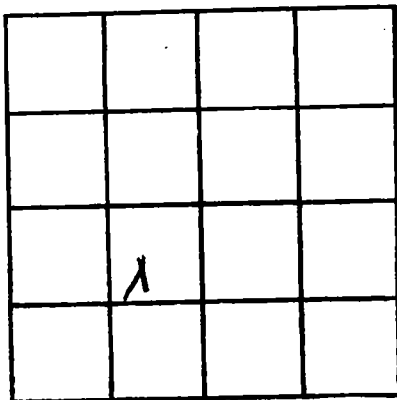

SECTION 26

Please indicate well location X.

ADDITIONAL INFORMATION

If more than one screen, show locations of each on sketch.