

Harrison
E 78
9-8-73

MISSISSIPPI
 BOARD OF WATER COMMISSIONERS
 416 North State Street
 Jackson, Mississippi 39201

CODED

WATER WELL DRILLERS LOG

8-8-73 19 RT Moore Harrison
 date well completed firm name county well located

LANDOWNER: JIM K HUN
208 AlOCKADO Drive

| description of formations encountered | from | to |
|---------------------------------------|------------|------------|
| <u>TOP SOIL</u> | <u>0</u> | <u>10</u> |
| <u>White Clay</u> | <u>10</u> | <u>30</u> |
| <u>RSTY Shrd</u> | <u>30</u> | <u>50</u> |
| <u>Blue Clay</u> | <u>50</u> | <u>200</u> |
| <u>Gray Shrd</u> | <u>200</u> | <u>250</u> |
| | | |
| | | |
LONG Beasel, MISS
 (mailing address)

WELL LOCATION:
 sec. 7 T. 6 S. R. 13 E.
4 miles NA of PODOLSKY SCHOOL
 (distance) (direction) (nearest town)

WELL PURPOSE:
 home irrigation, municipal, industrial

WELL COMPLETION DATA:

(1) diameter (inches) 2"

(2) total depth (feet) 250'

(3) static water level (feet) 12' below above top of ground.

(4) casing gpm 240'
 (material) (depth)
 _____ if telescope see back. (size)

(5) screen 10' 240'
 (length) (depth to top)
8" SS
 (size) (material)

(6) pump _____ (HP) _____ (yield gpm)
 _____ (type power)

(7) electric log _____ (yes or no)
 _____ (organization running log)

(8) how well bottom plugged By stone

CODED


SEP 7 1973

DRILLERS REMARKS:

MISS. STATE WATER...

If well telescopes please sketch and show depths.

GROUND LEVEL

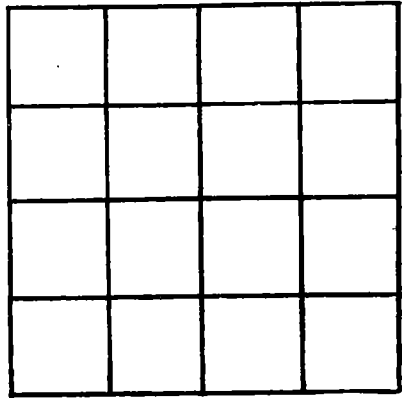

SECTION _____

Please indicate well location X.

ADDITIONAL INFORMATION

If more than one screen, show locations of each on sketch.