

MISSISSIPPI  
BOARD OF WATER COMMISSIONERS  
416 North State Street  
Jackson, Mississippi 39201

**CODED**

WATER WELL DRILLERS LOG


Harrison  
E 79  
8-14-73

8-14-73 19 R. P. Moore HARRISON  
date well completed firm name county well located

LANDOWNER: <u>Rodaleit Landers</u>	description of formations encountered	from	to
<u>RT 2 Box 322A</u>	<u>TOP Soil</u>	<u>0</u>	<u>10</u>
<u>Pass Christian MISS</u> (mailing address)	<u>Reddy Sand</u>	<u>10</u>	<u>100</u>
WELL LOCATION:	<u>White Clay</u>	<u>100</u>	<u>110</u>
sec. <u>33</u> T. <u>6</u> N. R. <u>13</u> E	<u>Reddy Sand</u>	<u>110</u>	<u>140</u>
<u>7</u> miles <u>N</u> of <u>Pass Christian</u> (distance) (direction) (nearest town)	<u>Blue Clay</u>	<u>140</u>	<u>390</u>
WELL PURPOSE: (home, irrigation, municipal, industrial)	<u>Grey Sand</u>	<u>390</u>	<u>453</u>
WELL COMPLETION DATA:	<b>CODED</b>		
(1) diameter (inches) <u>2'</u>			
(2) total depth (feet) <u>453'</u>			
(3) static water level (feet) <u>60'</u> <u>below</u> above top of ground.			
(4) casing <u>4 1/2"</u> <u>4 1/2'</u> (material) (depth)			
(size) If telescope see back.			
(5) screen <u>10'</u> <u>453'</u> (length) (depth to top)			
<u>2"</u> <u>SS</u> (size) (material)			
(6) pump <u>-</u> <u>-</u> (HP) (yield gpm)			
(type power)			
(7) electric log <u>-</u> (yes or no)			
(organization running log)			
(8) how well bottom plugged <u>By 7' line</u>			
DRILLERS REMARKS:	1973		

If well telescopes please sketch and show depths.

GROUND LEVEL

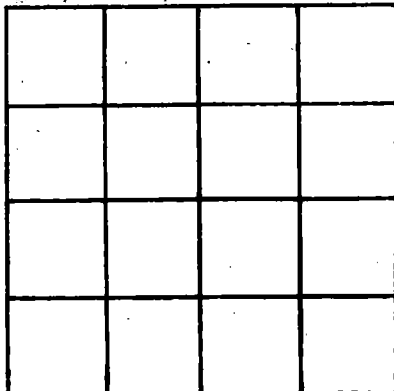

SECTION \_\_\_\_\_

Please indicate well location X.

ADDITIONAL INFORMATION

If more than one screen, show locations of each on sketch.