

**HARRISON**  
**E 80**  
**12-16-73**  
**10**

MISSISSIPPI  
 BOARD OF WATER COMMISSIONERS  
 416 North State Street  
 Jackson, Mississippi 39201 **CODED**

**WATER WELL DRILLERS LOG**

Dec. 16 1973 McGill Well Works Harrison  
 date well completed firm name county well located

LANDOWNER: Robert Wages  
Rt. 1, Box 659C  
Gulfport, Miss.  
 (mailing address)

WELL LOCATION:  
 sec. 33 T 6 N R 13 E  
S W  
8 miles S.W. of Lagrange  
 (distance) (direction) (nearest town)

WELL PURPOSE: None  
 (home, irrigation, municipal, industrial)

WELL COMPLETION DATA:

(1) diameter (inches) 2''

(2) total depth (feet) 378'

(3) static water level (feet) 58' below above  
 top of ground.

(4) casing gal. 368'  
 (material) (depth)

- if telescope see back.  
 (size)

(5) screen 2'' -  
 (length) (depth to top)

10' S.S.  
 (size) (material)

(6) pump 1 8  
 (HP) (yield gpm)

Electric  
 (type power)

(7) electric log no  
 (yes or no)

-  
 (organization running log)

(8) how well bottom plugged hard  
hard

description of formations encountered	from	to
<u>clay</u>	<u>0</u>	<u>33</u>
<u>course sand</u>	<u>33</u>	<u>91</u>
<u>blue clay</u>	<u>91</u>	<u>168</u>
<u>slush</u>	<u>168</u>	<u>337</u>
<u>fine sand</u>	<u>237</u>	<u>378</u>
<u>slush</u>	<u>278</u>	<u>315</u>
<u>blue clay</u>	<u>315</u>	<u>352</u>
<u>course sand</u>	<u>352</u>	<u>378</u>


**CODED**

DRILLERS REMARKS:

NOV 27 1973

If well telescopes please sketch and show depths.

GROUND LEVEL

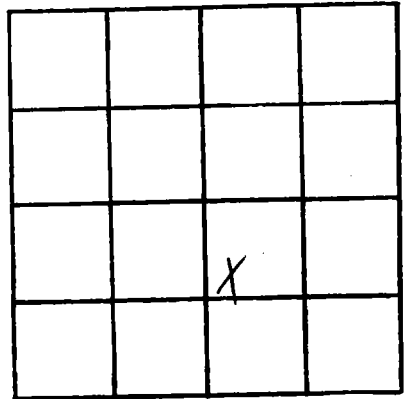

SECTION 33

Please indicate well location X.

ADDITIONAL INFORMATION

If more than one screen,  
show locations of each on sketch.