

HARRISON
E 84
2-2-74

MISSISSIPPI
 BOARD OF WATER COMMISSIONERS
 416 North State Street
 Jackson, Mississippi 39201

CODED

WATER WELL DRILLERS LOG
 COASTAL DRILLING & SERVICE CO.

date well completed 7/2 1974 ROUTE 1 BOX 618 county well located Howell

LANDOWNER: W. Harrison
P.O. Box 1377
Yuleport, Miss.
 (mailing address)

WELL LOCATION:
 sec. 9 T. 6 N. R. 13 E.
(4) Four miles west of Ligona
 (distance) (direction) (nearest town)

WELL PURPOSE: home
 (home, irrigation, municipal, industrial)

WELL COMPLETION DATA:

(1) diameter (inches) 2"

(2) total depth (feet) 420'

(3) static water level (feet) 100 below above top of ground.

(4) casing PVC, 4 1/2" (material) (depth)

 If telescope see back.
 (size)

(5) screen 10', 4 1/2" (length) (depth to top)

2", PVC (size) (material)

(6) pump 1/2, 15 (HP) (yield gpm)

5' 1/2" (type power)

(7) electric log no (yes or no)

 (organization running log)

description of formations encountered	from	to
Top Soil	1	3
Red Clay	3	18
Sugar Sand	18	105
Coarse white sand	105	165
Blue Clay	165	220
fine white sand	220	235
Hard Blue Clay	235	370
fine white sand	370	380
Coarse white sand	380	420

CODED


DRILLERS REMARKS

AUG 15 1974

(8) how well bottom plugged 2 1/2"
W. Harrison
 DRILLERS REMARKS:
name

If well telescopes please sketch and show depths.

GROUND LEVEL

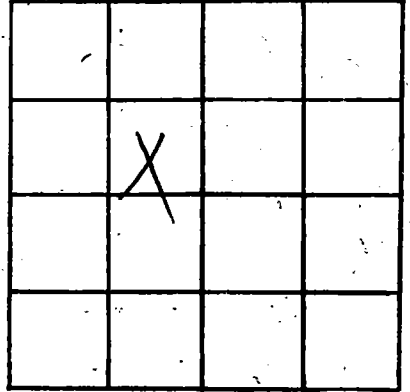

SECTION _____

Please indicate well location X.

ADDITIONAL INFORMATION

If more than one screen, show locations of each on sketch.