


**Harrison**  
**E 85**  
**9-12-73**

MISSISSIPPI  
 BOARD OF WATER COMMISSIONERS  
 416 North State Street  
 Jackson, Mississippi 39201

CODEE


WATER WELL DRILLERS LOG

September 12 1973 H.A. Hadwier's Wellworks HARRISON  
 date well completed firm name county well located

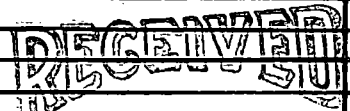LANDOWNER: <u>Netto</u>	description of formations encountered	from	to
<u>Dedeaux, Miss.</u> (mailing address)	<u>yellow clay</u>	<u>0</u>	<u>60</u>
WELL LOCATION: sec <u>4</u> T <u>6</u> R <u>B</u> <u>4</u> miles <u>SE</u> of <u>Vidalia</u> (distance) (direction) (nearest town)	<u>yellow sand</u>	<u>60</u>	<u>90</u>
WELL PURPOSE: <u>HOME</u> (home, irrigation, municipal, industrial)	<u>yellow clay</u>	<u>90</u>	<u>180</u>
WELL COMPLETION DATA: (1) diameter (inches) <u>2 inch</u>	<u>blue clay</u>	<u>180</u>	<u>325</u>
(2) total depth (feet) <u>367 FT.</u>	<u>blue sand</u>	<u>325</u>	<u>367</u>
(3) static water level (feet) <u>60</u> below top of ground.			
(4) casing <u>Galv.</u> , <u>357 ft.</u> (material) (depth) <u>2 inch</u> if telescope see back. (size)			
(5) screen <u>10 ft.</u> , <u>357 ft.</u> (length) (depth to top) <u>2 inch, stainless steel</u> (size) (material)			
(6) pump <u>2</u> <u>7</u> (HP) (yield gpm) <u>Electric</u> (type power)			
(7) electric log <u>No</u> (yes or no)			
(organization running log)			
(8) how well bottom plugged <u>Ball Check</u>			
DRILLERS REMARKS:	 NOV - 4 1974		

If well telescopes please sketch and show depths.

GROUND LEVEL

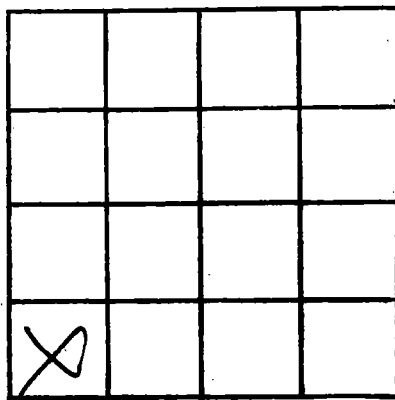

SECTION 4

Please indicate well location X.

ADDITIONAL INFORMATION

If more than one screen, show locations of each on sketch.