

HARRISON
E87
4-6-74

MISSISSIPPI
BOARD OF WATER COMMISSIONERS
416 North State Street
Jackson, Mississippi 39201

CODED

WATER WELL DRILLERS LOG

April 6 1974 McGil Well Works Harrison
date well completed firm name county well located

LANDOWNER: Kenneth Malley
Rt 1 Box 620
Pass Christian Miss.
(mailing address)


description of formations encountered	from	to
sand	0	38
Blue clay	38	87
slush	87	121
Blue clay	121	168
fine sand	168	204
slush	204	261
Blue clay	261	297
slush	297	342
Blue clay	342	391
coarse sand	391	415

WELL LOCATION:
sec. 22 T 6 N R 13 E
12 miles N of Pass Christian
(distance) (direction) (nearest town)

WELL PURPOSE: Home
(home, irrigation, municipal, industrial)

WELL COMPLETION DATA:
(1) diameter (inches) 2"
(2) total depth (feet) 415'
(3) static water level (feet) 80' below top of ground
(4) casing P.V.C. 405'
(material) (depth)
If telescope see back.
(size)
(5) screen 10' 2"
(length) (depth to top) (size) (material)
(6) pump 1 7
(HP) (yield gpm)
Electric
(type power)
(7) electric log no
(yes or no)
(organization running log)

(8) how well bottom plugged sand
shank, back wash valve
DRILLERS REMARKS:

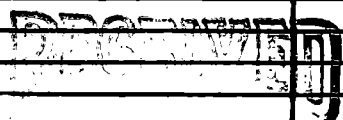

JAN 27 1975

MISS. BD. OF WATER COMM

If well telescopes please sketch and show depths.

GROUND LEVEL

			X

SECTION 22

Please indicate well location X.

ADDITIONAL INFORMATION

If more than one screen, show locations of each on sketch.