

HARRISON  
 Shallow well  
 E 88  
 6-3-74

MISSISSIPPI  
 BOARD OF WATER COMMISSIONERS  
 416 North State Street  
 Jackson, Mississippi 39201 CODED

WATER WELL DRILLERS LOG

June 3 1974 Mc Gill well works Harrison  
 date well completed firm name county well located

LANDOWNER: Lionel Moran	description of formations encountered	from	to
Del. Del. Delisle, Miss (mailing address)			
WELL LOCATION: sec. 26 T 6 N R 3 E 14 miles N of Pass Christian (distance) (direction) (nearest town)			
WELL PURPOSE: home (home, irrigation, municipal, industrial)			
WELL COMPLETION DATA: (1) diameter (inches) 2" (2) total depth (feet) 90' (3) static water level (feet) 20' below top of ground (4) casing 2" PVC 80' (material) (depth) (size) If telescope see back. (5) screen 10' 80' (length) (depth to top) (size) 2" (material) plastic (6) pump 1 8 (HP) (yield gpm) Electric (type power) (7) electric log NO (yes or no) (organization running log) (8) how well bottom plugged sandstone - back wash valve			
DRILLERS REMARKS:			


CODED

RECEIVED  
 MISSISSIPPI  
 BOARD OF WATER COMMISSIONERS

JAN 21 1975

If well telescopes please sketch and show depths.

GROUND LEVEL

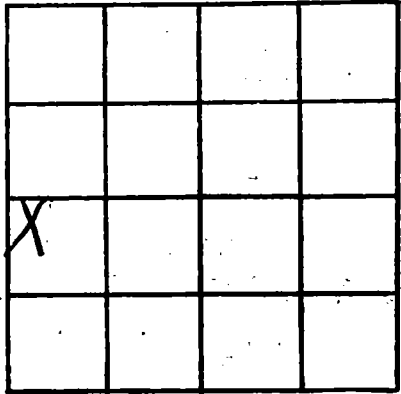

SECTION 26

Please indicate well location X.

ADDITIONAL INFORMATION

If more than one screen, show locations of each on sketch.