

HAR.

MISSISSIPPI BOARD OF WATER COMMISSIONERS

F.C. 9-9-60

M524203 92

WATER WELL DRILLERS LOG

Date: 9-9, 1960, Driller: H'berg Butane County Harrison

(Name)

(1) Owner of Land: Albert Saucier (Name) Rt 1 Box 66 Saucier (Address)

Table with 3 columns: Description & Color of Materials, Thickness Feet, Depth Feet. Contains entries for Blue Clay and Sand.

(2) Location: 1/4, 1/4, Sec. 11 T. 6 R. 13, miles, of

(3) Topography: (Hilly) (Flat) (Level)


(4) Purpose of Well: domestic (Domestic Irrigation, Municipal, Industrial, Other)

Information upon completion of well:

- (1) Diameter 2 inches. (2) Total Depth 400 feet. (3) Water Level 84 feet below top of ground. (4) Cased to, Size. (5) Screen: Size 2", Length 10'. (6) Were any formations sealed against pollution? yes, X no.

If YES depth of formation Why


Drillers Remarks: old well 220', went deeper (down to 400')

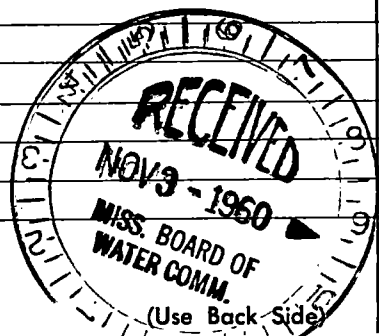

Well No.

1000

1000

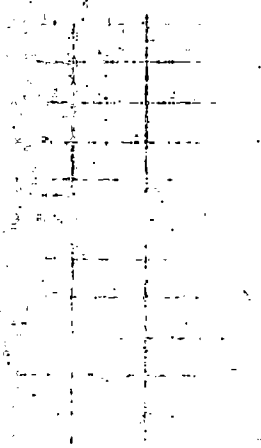

1000

