

MISSISSIPPI DEPARTMENT OF NATURAL RESOURCES

Bureau of Land and Water Resources

Southport Mall

P.O. Box 10631

Jackson, Mississippi 39209

WATER WELL DRILLERS LOG

13

E94
HARRISON
6-20-83

CODED

6/20 1983
date well completed

83 Rogers Well Co.
firm name

Harrison
county well located

LANDOWNER: Don Hanna
P.O. Box 3593 Apt 39501
(mailing address)

description of formations encountered	from	to
Big Gravel	0	50
fine to medium sand	50	85
Blue Clay	85	190
yellow sand	190	210
Blue Clay	210	280
fine sand & clay	280	348
Blue Clay	348	484
fine sand	484	506
Blue Clay	506	599
Good sand	599	665

WELL LOCATION:
sec. 13 T. 6 N. R. 13 E.
20 miles NW of Long Beach
(distance) (direction) (nearest town)

WELL PURPOSE: None
(home, irrigation, municipal, industrial)



- WELL COMPLETION DATA:
- (1) diameter (inches) 4x2"
 - (2) total depth (feet) 665
 - (3) static water level (feet) 80' below top of ground.
 - (4) casing PVC, 645'
(material) (depth)
4x2 If telescope see back.
(size)
 - (5) screen 20', 665'
(length) (depth to top)
2" PVC
(size) (material)
 - (6) pump 1 34
(HP) (yield gpm)
Elect.
(type power)
 - (7) electric log NO
(yes or no)
NO
(organization running log) sand shark
 - (8) how well bottom plugged shark

DEPT. OF NATURAL RESOURCES
BUREAU OF LAND & WATER RESOURCES
MAY 11 1984
RECEIVED

DRILLERS REMARKS:

If well telescopes please sketch and show depths.

GROUND LEVEL

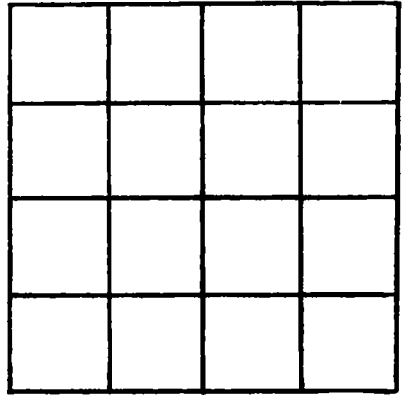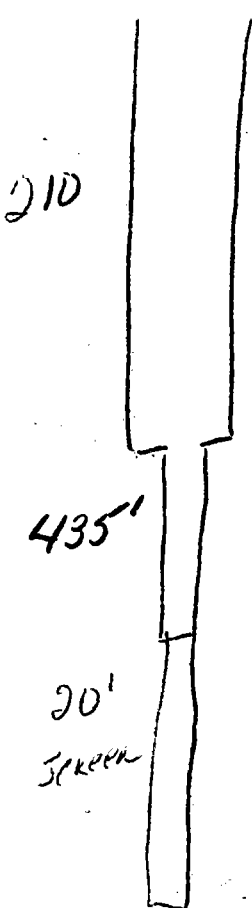

SECTION _____

Please indicate well location X.

ADDITIONAL INFORMATION

A series of horizontal lines for providing additional information.

If more than one screen, show locations of each on sketch.