

MISSISSIPPI DEPARTMENT OF NATURAL RESOURCES

Bureau of Land and Water Resources

Southport Mall

P.O. Box 10631

Jackson, Mississippi 39209

WATER WELL DRILLERS LOG

CODED

HARRISON
E 97
5/28/84

5/28/84 19 Lyman Well Co. county well located

LANDOWNER: A. E. Allen
Rt. 9, Box 334
Southport, MS 39503
(mailing address)

WELL LOCATION:
sec 33 T 6 N R 13 E
20 miles (distance) N (direction) of Pass (nearest town)

WELL PURPOSE: None
(home, irrigation, municipal, industrial)

- WELL COMPLETION DATA:
- (1) diameter (inches) 4x2
 - (2) total depth (feet) 447'
 - (3) static water level (feet) 70' below above top of ground.
 - (4) casing PVC 427'
(material) (depth)
4x2 if telescope see back.
(size)
 - (5) screen 20' 427'
(length) (depth to top)
2" PVC
(size) (material)
 - (6) pump 1 1/2 45
(HP) (yield gpm)
electric
(type power)
 - (7) electric log NO
(yes or no)
NO
(organization running log)
 - (8) how well bottom plugged sand
shark

description of formations encountered	from	to
Red sand Blawie clay	0	120
Green Gumbo	120	160
Light Sand	160	195
Blue Clay	195	290
Mixed sand & clay	290	340
Blue Clay	340	420
Good Sand	420	447

CODED

DEPT. OF NATURAL RESOURCES
BUREAU OF LAND & WATER RESOURCES


SEP 5 1984

RECEIVED

DRILLERS REMARKS:

If well telescopes please sketch and show depths.

GROUND LEVEL

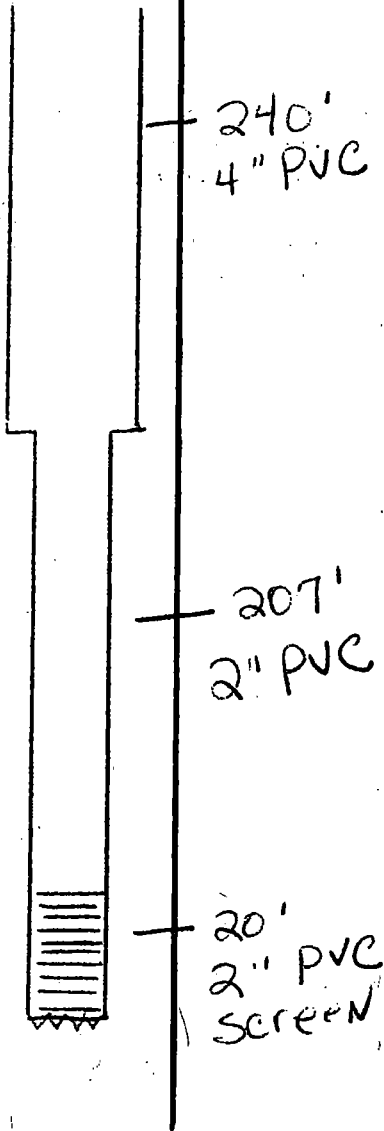

		X	

SECTION 33

Please indicate well location X.

ADDITIONAL INFORMATION

If more than one screen, show locations of each on sketch.