

MISSISSIPPI DEPARTMENT OF NATURAL RESOURCES

Bureau of Land and Water Resources

Southport Mall

P.O. Box 10631

Jackson, Mississippi 39209

WATER WELL DRILLERS LOG

HARRISON
E 98
3-23-85

Mar. 23 1985 Ward Well Dr. Harrison
 date well completed firm name county well located

LANDOWNER: Shoald Holliman
Vidalia Rd.
Pass Christian, ms.
 (mailing address)


WELL LOCATION:
 sec 30 T 6 N R 13 E
17 miles N/W of De Sade
 (distance) (direction) (nearest town)

WELL PURPOSE: Home
 (home, irrigation, municipal, industrial)

- WELL COMPLETION DATA:
- (1) diameter (inches) 2"
 - (2) total depth (feet) 420
 - (3) static water level (feet) 80 below top of ground.
 - (4) casing PVC, 410',
 (material) (depth)
 (size) if telescope see back.
 - (5) screen 10', -
 (length) (depth to top)
2", PVC
 (size) (material)
 - (6) pump owner, -
 (HP) (yield gpm)
 (type power)
 - (7) electric log NO
 (yes or no)
N/A
 (organization running log)
 - (8) how well bottom plugged BVV

description of formations encountered	from	to
Clay	0	48
sd w/ka hard	48	65
sd clay	65	130
Clay - silt	130	384
Coal sd	384	420

DRILLERS REMARKS: N/A

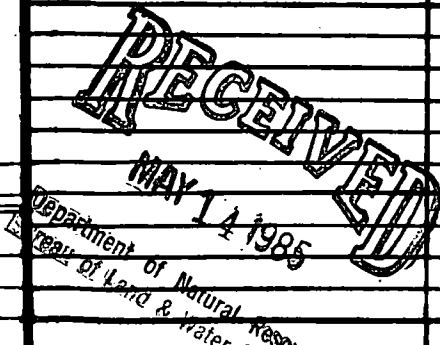

If well telescopes please sketch and show depths.

GROUND LEVEL

X			

SECTION 30

Please indicate well location X.

ADDITIONAL INFORMATION

If more than one screen, show locations of each on sketch.