

MISSISSIPPI DEPARTMENT OF ENVIRONMENTAL QUALITY

Office of Land and Water Resources

P. O. Box 10631
Jackson, MS 39289-0631

WATER WELL DRILLERS LOG

COUNTY WELL LOCATED <i>Harrison</i>	
WELL NUMBER <i>E-131</i>	CODED
DATE WELL COMPLETED <i>Aug 13, 02</i>	

PERMIT NUMBER
NAME OF DRILLING FIRM <i>M+M Well</i>
<i>8827 Boss Huskey Rd</i>

NAME & MAILING ADDRESS OF LANDOWNER <i>Classic Homes</i>			
<i>24028 Road 574</i>			
Latitude: <i>Saucier, Mo.</i>			
Longitude: <i>Saucier, Mo.</i>			
WELL LOCATION	SEC	TOWNSHIP	RANGE
	<i>12</i>	<i>6S</i>	<i>R3E</i>
DISTANCE	DIRECTION	NEAREST TOWN	
<i>3</i>	<i>Miles East of Logansport</i>		
OTHER LANDMARK <i>1/4 miles south of Jackie's gro.</i>			
WELL PURPOSE: Home, Irrigation, Municipal, Industrial, Fish Pond, etc. <i>Home</i>			

PUMP DATA	
PUMP TYPE (Circle One): Submersible, Turbine, <input checked="" type="radio"/> <i>Flowing Well</i> , Other (Describe) _____	
POWER TYPE (Circle One): <input checked="" type="radio"/> <i>Electric</i> , Tractor, Diesel, Gasoline, Butane, Other (Describe) _____ H/P <i>1</i>	

DESCRIPTION OF FORMATIONS ENCOUNTERED	FROM	TO
TOP SOIL		
<i>TOP SOIL</i>	<i>1</i>	<i>4</i>
<i>& heavy sand</i>	<i>4</i>	<i>60</i>
<i>White CLAY</i>	<i>60</i>	<i>100</i>
<i>GRAY CLAY</i>	<i>100</i>	<i>200</i>
<i>sand</i>	<i>200</i>	<i>240</i>

WELL DATA		
Well Depth <i>230</i>	Casing Diameter (In.) <i>2"</i>	Casing Length (Ft.) <i>230'</i>
Type of Casing <i>PVC</i>	Hole Depth <i>240</i>	Depth to Static Water Level <i>70'</i>
TYPE OF COMPLETION: (Circle One or More): <input checked="" type="checkbox"/> <i>Gravel Packed</i> , <input type="checkbox"/> <i>Underreamed</i> , <input type="checkbox"/> <i>Telescoped</i> , <input checked="" type="checkbox"/> <i>Natural Development</i> , <input type="checkbox"/> <i>Open Hole</i> , <input type="checkbox"/> <i>Other</i> (Describe) _____		
WELL GROUTED TO A DEPTH OF <i>11</i> FEET Type Grout (circle one): Cement, Bentonite, or Mix		

SCREEN DATA		
Diameter - Inches <i>2"</i>	Length - Feet <i>10'</i>	Slot Size - Inches <i>.006</i>
Screen Type <i>PVC</i>	Depth to Bottom - Feet <i>240'</i> <i>230-240</i>	

RECEIVED

FEB 10 2003

BY: OLWR

Top of Lap Pipe or Reduction in Casing

FEET IF TELESCOPED OR MORE THAN ONE SCREEN: USE BACK PAGE


I certify that the well was drilled, constructed and completed in accordance with all applicable Requirements of the Mississippi Department of Environmental Quality and/or the Mississippi Department of Health regulations and state laws.

Ala Morda - 0563 *Feb 6, 03*
Signature of Licensed Driller and License No. Date

Additional Information Required On Back

If well telescopes please sketch and show depths.

GROUND LEVEL

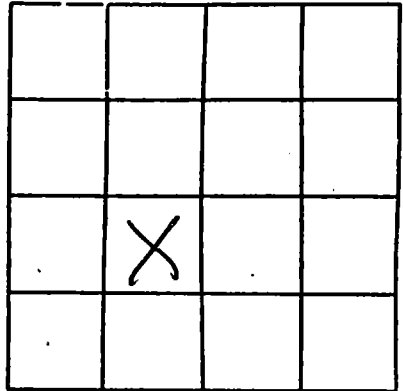

SECTION 12

Please indicate well location X.

Pump Capacity (GPM)	No. of Stages	Setting Depth	
<u>12</u>	<u>2</u>	<u>90'</u>	FT.

PUMP TEST

Well yielded 11 GPM with
a drawdown of 20' ft.
after _____ hours of pumping

LOG DATA

TYPE OF LOG RUN (Circle One): No Log Run, Electric, Gamma Ray, Density, Sonic, Neutron, Other (Describe) _____

Name of Organization Running Log

GEOLOGIC DATA (Office Use Only)

Surface Elev.	Geologic Unit	Unit Thickness	Depth to Top
Subs. SWL	Date	Analysis	Aquifer Test

Driller's Remarks

If more than one screen, show location of each on sketch.