

MISSISSIPPI DEPARTMENT OF ENVIRONMENTAL QUALITY

Office of Land and Water Resources

P. O. Box 10631

Jackson, MS 39289-0631

WATER WELL DRILLERS LOG

COUNTY WELL LOCATED HARRISON	
WELL NUMBER E-139	CODED
DATE WELL COMPLETED 02/25/03	

PERMIT NUMBER 0339
NAME OF DRILLING FIRM McGill Pump & Well

NAME & MAILING ADDRESS OF LANDOWNER Price Construction			
14476 Cable Bridge Rd. Grt. Ms. 39503			
Latitude: (228) 832-1856			
Longitude:			
WELL LOCATION	SEC 24	TOWNSHIP 6	RANGE 13 E
DISTANCE 8 Miles	DIRECTION W	NEAREST TOWN GRY.	
OTHER LANDMARK Corner Cemetery Rd.			
WELL PURPOSE: <input checked="" type="checkbox"/> Home Irrigation, <input type="checkbox"/> Municipal, <input type="checkbox"/> Industrial, <input type="checkbox"/> Fish Pond, etc.			

PUMP DATA		
PUMP TYPE (Circle One): Submersible, Turbine, Jet, Flowing Well, Other (Describe) _____		
POWER TYPE (Circle One): Electric, Tractor, Diesel, Gasoline, Butane, Other (Describe) _____ H/P _____		
DESCRIPTION OF FORMATIONS ENCOUNTERED	FROM	TO
MUD (YELLOW)	20	80
MUD/SAND (BLUE)	80	120
MUD (BLUE)	120	160
MUD/SAND (BLUE)	160	200
MUD (BLUE)	200	240
SAND (BLUE)	240	300

WELL DATA		
Well Depth 300	Casing Diameter (In.) 2"	Casing Length (Ft.) 280
Type of Casing PVC	Hole Depth 300	Depth to Static Water Level 80
TYPE OF COMPLETION: (Circle One or More): <input checked="" type="checkbox"/> Gravel Packed, <input type="checkbox"/> Underreamed, <input type="checkbox"/> Telescoped, <input checked="" type="checkbox"/> Natural Development, <input type="checkbox"/> Open Hole, <input type="checkbox"/> Other (Describe) _____		
WELL GROUTED TO A DEPTH OF 10 FEET Type Grout (circle one): Cement, Bentonite, or Mix		

SCREEN DATA		
Diameter - Inches 2"	Length - Feet 20'	Slot Size - Inches .0026
Screen Type PVC	Depth to Bottom - Feet 300	

RECEIVED	
MAR 14 2003	
BY: OLWR	
Top of Lap Pipe or Reduction in Casing	FEET
	IF TELESCOPED OR MORE THAN ONE SCREEN: USE BACK PAGE

I certify that the well was drilled, constructed and completed in accordance with all applicable Requirements of the Mississippi Department of Environmental Quality and/or the Mississippi Department of Health regulations and state laws.


Mike McDie
Signature of Licensed Driller and License No.

03/12/03
Date

Additional Information Required On Back

If well telescopes please sketch and show depths.

GROUND LEVEL

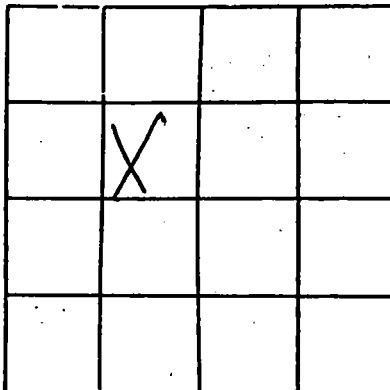

SECTION _____

Please indicate well location X.

Pump Capacity (GPM)	No. of Stages	Setting Depth	
12	2	100	FT.

PUMP TEST

Well yielded 8 GPM with
a drawdown of 10 ft.
after 12 hours of pumping

LOG DATA

TYPE OF LOG RUN (Circle One): No Log Run
Electric, Gamma Ray, Density, Sonic, Neutron,
Other (Describe) _____

Name of Organization Running Log

GEOLOGIC DATA (Office Use Only)

Surface Elev.	Geologic Unit	Unit Thickness	Depth to Top
Subs. SWL	Date	Analysis	Aquifer Test

Driller's Remarks

If more than one screen,
show location of each on sketch.