

State Well Report

Part 1 - Driller's Log

Mississippi Department of Environmental Quality
Office of Land and Water Resources
P.O. Box 10631
Jackson, MS 39289-0631
(601)961-5210
(601)354-6938 (fax)

County: Harrison
 Permit #: _____
 Driller: O-785
 Date drilling completed: 5-23-08

For Office Use Only:

Aquifer: _____
 Well #: E-180
 L. S. Elevation: _____
 E-log #: _____

State Law requires that this report be prepared by the license holder responsible for the work and filed with the Department at the above address within 30 days of completion of drilling of the well or borehole.

Information on Well Owner <small>(Landowner if borehole is not for a water well)</small>	Well or Borehole Location
Owner Name: <u>Larry Hilton</u>	Latitude: <u>30° 32' 65.3"</u> Longitude: <u>89° 15' 49.5"</u>
Mailing Address: <u>25021</u> <u>Wallace Saucier Rd.</u> <u>Gpt. Ms. 39503</u> City State Zip Code	Method of Lat/Long (circle one): Conventional Survey, <u>39</u> USGS quad: <u>Hand-held GPS</u> Survey-grade GPS <u>29</u>
Telephone No. () <u>832-6929</u>	_____ 1/4 _____ 1/4 Sec <u>12</u> Twn <u>6S</u> Rng <u>13W</u>
	Distance _____ Direction _____ Nearest Town _____ Miles _____ of _____

Well / Borehole Data

Date drilling started: 5-23 Date drilling completed: 5-23 Hole depth: 460' Hole diameter: 5"

Location of the source of any surface water used for drilling: _____
 Method of dosing and volume of Chlorine used in drilling and development: _____

Logs run (circle all applicable): No log run Electric Gamma Ray Density Sonic Neutron Other: _____
 Name of organization running log(s): _____

Purpose of borehole (check one): Water Well Geotechnical/Geological Investigation _____ Ground Source Heat Pump _____
 Seismic Survey _____ Other (describe) _____

If drilling is not related to water well construction, skip the remainder of this block

Purpose of Well (check one): Home Industrial _____ Public Supply _____ Irrigation _____ Fish Culture _____ Other: _____

If a flowing well, method of flow regulation: Valve _____ Other (describe) _____

Static Water Level: 110 feet above or below (circle one) land surface Date measured: 5-23

Method of Measurement (circle one) steel tape electric tape air line other: _____

Well depth: 460 Well grouted to a depth of 15 feet Type of grout (circle one): Neat Cement Bentonite Mix
 Casing length: 440 feet Casing diameter: 3" 2.25" inches Type of casing: PVC
 Screen length: 20 feet Screen diameter: 2 inches Type of screen: PVC
 Screen slot size: .006 inches Setting depth: From 440 feet to 460 feet

Type of completion (circle all applicable): Gravel packed Underreamed Telescoped Open hole Natural Development
 Other (describe): _____

Top of lap pipe or reduction in casing: _____ feet. *If telescoped or more than one screen, describe on next page*

Form: OLWR-SWR-1A


RECEIVED
 JUN 16 2008
 BY: OLWR

E-180

The sketch below only required for water wells

Description of formations encountered must be provided for all wells and boreholes, unless specifically exempted by regulations

If well telescopes, show depths on sketch.

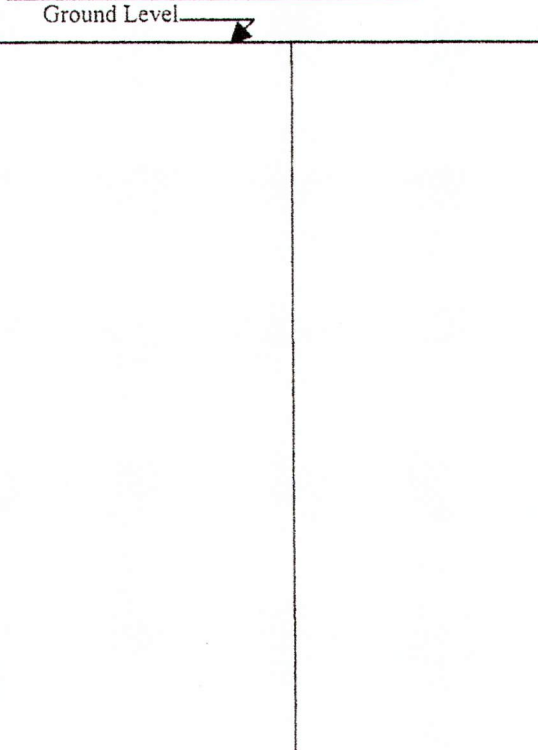

Description of Formations Encountered	From (depth)	To (depth)
Clay	Ground Level	30
Sand	30	90
Clay	90	125
Clay Sand	125	145
Clay	145	150
Sand	150	200
Clay	200	220
Sand	220	230
Clay	230	310
Sand	310	320
Clay	320	420
Sand	420	460

If more than one screen, show location of each on sketch

Sketch the property layout and include the following: 1) the well location; 2) any permanent structures on the property that may aid in locating the well; 3) any roads, power lines, or other items that may aid in locating the property and the well; 4) a north arrow.



Landowner Name: Larry Hilton

RECEIVED
 JUN 16 2008
 BY: OLWR

Form: OLWR-SWR-1A

I certify that the well/borehole was drilled, constructed, and completed in accordance with all applicable requirements of the Mississippi Department of Environmental Quality and the Mississippi Department of Health regulations, if applicable, and state laws.

MALVIN WAGNON 0-785 5-23-08 Malvin Waggon
 Print Name of Responsible Licensee and License No. Date Signature of Licensee

STATE WELL REPORT

Part 2

Pump Installer's Completion Report
 Mississippi Department of Environmental Quality
 Office of Land and Water Resources
 P.O. Box 10631
 Jackson, MS 39289-0631
 (601)961-5210
 (601)354-6938 (fax)

County: Harrison
 Permit #: _____
 Driller: 0-785
 Date completed: 5-27-08
Copy information from block on Part 1

For Office Use Only:

Aquifer: _____
 Well #: E-180
 Elevation: _____

This part of the report must be completed by a licensed water well contractor or a licensed pump installer. A copy of Part 1 of the report must be attached and both parts filed with the Department at the above address within 30 days of well completion.

Well Owner Information	Well Location
Owner Name: <u>Larry Hilton</u>	Latitude: <u>30° 32.653'</u> Longitude: <u>89° 15.485'</u>
Mailing Address: <u>25021</u> <u>Wallace Sancier Rd.</u> <u>Gpt. Ms. 39507</u> City State Zip Code	Method of Lat/Long (check one): Conventional Survey _____ USGS quad _____, Hand-held GPS <input checked="" type="checkbox"/> , Survey-grade GPS _____ _____ 1/4 _____ 1/4 Sec _____ T _____ R _____
Telephone No. () <u>832-6929</u>	Distance _____ Direction _____ Nearest Town _____ _____ Miles _____ of _____

Pump Type Circle one	Power Type Circle one
Air Lift Jet <input checked="" type="radio"/> Submersible	Diesel Engine Gasoline Engine Natural Gas
Bucket Piston Turbine	<input checked="" type="radio"/> Electric Motor Hand Tractor PTO
Centrifugal Rotary Flowing Well	Windmill Other (specify): _____
Other (specify): _____	Horse Power Rating of Motor: <u>1.5</u>
Date Pump Installed: <u>5-27-08</u>	Setting Depth: <u>140</u> feet
Rated Pump Capacity: <u>22</u> Gallons Per Minute	Number of Stages: _____

Pump Test Data	Method of Measuring Water Level Circle one
Date Well Tested: <u>5-27-08</u>	Air Line Electric Measuring Line <input checked="" type="radio"/> Steel Tape
Static Water Level (A): <u>110</u> Feet Below Land Surface	Other (specify): _____
Pumping Water Level (B): <u>140</u> Feet Below Land Surface	For flowing well, measured shut in head: _____ feet
Drawdown [(B) - (A)]: <u>30</u> Feet Below Land Surface	Well yielded _____ GPM with a drawdown of _____ feet after _____ hours of pumping
Test Pumping Rate: _____ Gallons Per Minute	
Duration of Pump Test (minimum 4 hours): <u>24</u> hours	

I HEREBY CERTIFY that the above statements are true to the best of my knowledge.

MALVIN WAGNON 0-785 Mali Wagon
 Print Name of Pump Installer and License No. (if applicable) Signature of Pump Installer

Form: OLWR-SWR-1B

RECEIVED
 JUN 16 2008
 BY: OLWR