	STATE WELL REPORT	78				
County: <u>Harrison</u> Permit #: Driller: <u>O-285</u> Date drilling completed: <u>2-5-19</u>	Part 1 Driller's Log Mississippi Department of Environmental Quali Office of Land and Water Resources P.O. Box 2309 Jackson, MS 39225-2309 (601)961-5555	For Office Use Only:				
	(601)961-5228 (fax) State Law requires that this report be prepared by the license holder responsible for the work and filed with the Department at the above address within 30 days of completion of drilling of the well or borehole.					
Well Owner Informat		orehole Location				
(Landowner if borehole is not for	Latitude: 30, 509/4	Longitude: 89,286248				
Owner Name: <u>Mr. Curen</u>	جد <u>ع</u> لي علي علي علي علي علي علي علي علي علي ع	89 - 17 - 27,58 one): Conventional Survey,				
Mailing Address: 15006		d GPS, Survey-grade GPS				
<u>George Ladn</u> <u>Gulfport</u> <u>City</u> State	28503 Zip Code <u>Miles</u>	$ec_{01} T_{65} R_{13}$				
Telephone No. ()	(Distance) (Direction	of n) (Nearest Town)				
	Well / Borehole Data					
Date drilling started: $2-5-12$ Date drilling completed: $2-5-19$ Hole depth: 190 Hole diameter: $5''$						
Location of the source of any surface water used for drilling:						
Method of dosing and volume of Chlorine used in drilling and development:						
Logs run (check all applicable): log run Electric Gamma Ray Density Sonic Neutron Other:						
Name of organization running log(s):						
	r Well Geotechnical/Geological Investigation					
Seismic Survey Other (describe)						
	lated to water well construction, skip the remain					
Purpose of Well (check all applicable): Home Industrial Public Supply Irrigation Fish Culture						
Other (describe):						
If a flowing well, method of flow regulation: Valve Other (<i>describe</i>)						
Static Water Level:						
Method of measurement (check one) Steel tape Electric tape Air line Other (describe):						
Well depth: 199 Well grouted to a depth of: 15 feet Type of grout (check one) Reat Cement Bentonite Mix						
Casing length: 180 feet Casing diameter: 2 inches Type of casing: PUC						
Screen length: <u>10</u> feet Screen diameter: <u>2</u> inches Type of screen: <u>PVC</u>						
Screen slot size: 1006 inches Setting depth: From 186 feet to 192 feet						
Type of completion (check all applicable) ravel packed Underreamed Open hole Natural Development						
Other (describe):						
Top of lap pipe or reduction in casing:feet						

. .

.

.

•

If telescoped or more than one screen, describe on next page


County: _	Harrison	
Permit #:		

For Office Use Only:

Well #: E199

The sketch below only required for water wells

If well telescopes, show depths on sketch.

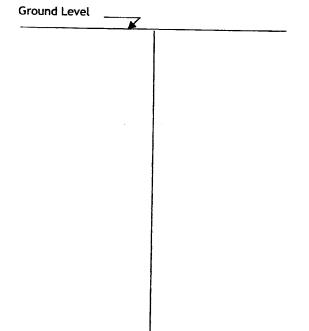

Description of formations encountered must be provided for all wells and boreholes, unless specifically exempted by regulations


Description of Formations Encountered	From (depth)	To (depth)
- Clay	Ground level	10
Sand	10	25-
Glay	25	180
·		
Sand	180	190
		· · · · · · · · · · · · · · · · · · ·

If more than one screen, show location of each on sketch

Sketch the property layout and include the following:

1) the well location

2) any permanent structures on the property that may aid in locating the well3) any roads, power lines, or other items that may aid in locating the property and the well 4) north arrow

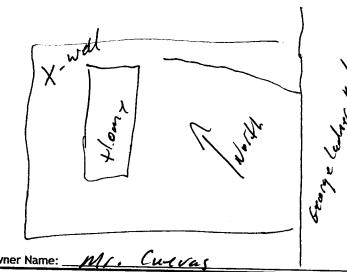

Landowner Name: Mr.

I HEREBY CERTIFY that the well/borehole was drilled, constructed, and completed in accordance with all applicable requirements of the Mississippi Department of Environmental Quality and the Mississippi Department of Health regulations, if applicable, and state laws.

MALVIN WAGNON 0-785-	2-5-19	N. C. Han
Print Name of Responsible Licensee and License No.	Date	Signature of Licensee

Form: OLWR-SWR-1B (4/13)

	STATE WELL REPORT			
County: Harrison	Part 2	For Office Use Only:		
Permit #:	Pump Installer's Completion Report Mississippi Department of Environmental Quality			
Driller: <u>P-759</u>	Office of Land and Water Resources	Well #: <u>E199</u>		
Date completed: 2-6-19	P.O. Box 2309 Jackson, MS 39225-2309	Aquifer:		
Copy information from block on Part 1	(601)961-5210			
	(601) 360-0535 (fax)			
of the report must be attached and both	d by a licensed water well contractor or a licensed pur parts filed with the Department at the above address w	np installer. A copy of Part 1 vithin 30 days of well completion.		
Well Owner Informati	TT WILL DO	ocation		
Owner Name: Mr. Cuavas	Latitude: 30, 50 916 Lon	gitude: 88,246248		
Mailing Address:): Conventional Survey,		
George Lada.	USGS quad, Hand-held G	PS, Survey-grade GPS		
Gulfpoct Ms City State	Mc 39507 State Zip Code SE 14 NE 14, Sec 21 T 6S R 13W			
Telephone No. ()	(Distance) (Direction)	(Nearest Town)		
	Pump Type (cheek one)			
Submersible	ugal Flowing Well Det Piston Rotary Dther (de	scribe).		
	Rated Pump Capacity:			
Is This Pump (check one): New Rep		Gallons Per Minute		
	Power Type (check one)	Anno an		
	Tractor PTO Windmill Other (describe):			
	Setting Depth:feet Number			
	Pump Test Data for Non Flowing Well			
Date Well Tested: $2 - 4 - 19$	Duration of Pump Test (minim	um 4 hours): 24 hours		
Static Water Level (A): <u>35</u> Feet Below Land Surface Pumping Water Level (B): <u>55</u> Feet Below Land Surface				
		Gallons Per Minute		
method of measurement (cneck one): St	eel tape Electric tape Air line Other (<i>describe</i>): _ Pump Test Data for Flowing Well			
Measured shut in head:feet.				
		h		
GPM with a d		hours of pumping		
	Meter Installation	RECEIVED		
	Meter Serial Number:			
	Type of Meter:			
Totalizer Register Unit and Multiplier Factor (AF x .001, gal x 1000, etc):				
Installation Date: Meter installed by: BYOLWR				
Is This Meter (check one): New Repaired Replacement				
Important: By submitting the above information you are certifying that this meter was installed to manufacturer standards. For agricultural wells, a list of approved meters is on the MDEQ website.				
I HEREBY CERTIFY that the above statements are true to the best of my knowledge.				
Regis Item P759 2-6-19 Rais Form				
France Naves of Pump Installer and Licen	se No. (if applicable) Date Signal	ture of Pump Installer		