

Harrison  
E 2001  
10-12-75

MISSISSIPPI  
BOARD OF WATER COMMISSIONERS  
416 North State Street  
Jackson, Mississippi 39201  
WATER WELL DRILLERS LOG

Oct. 12 1975 McGil well works Harrison  
date well completed firm name county well located

LANDOWNER: James Moran  
Rt 2 Box 2080  
Huffport miss.  
(mailing address)

WELL LOCATION:  
sec. 27 6N R. 13E 13S  
6 miles W. of Bayona  
(distance) (direction) (nearest town)

WELL PURPOSE: none  
(home, irrigation, municipal, industrial)

- WELL COMPLETION DATA:
- (1) diameter (inches) 2"
  - (2) total depth (feet) 609
  - (3) static water level (feet) 100' below above top of ground.
  - (4) casing plastic, 599' (material) (depth)
  - (size) If telescope see back.
  - (5) screen 10' (length) (depth to top)  
2" (size) 3.5 (material)
  - (6) pump 1 (HP) 5 (yield gpm)  
electric (type power)
  - (7) electric log no (yes or no)

(organization running log)  
(8) how well bottom plugged sand  
thick


DRILLERS REMARKS:

description of formations encountered	from	to
clay	0	20
Red sand	20	68
White clay	68	105
slush	105	137
L. sand	137	168
slush	168	193
Blue mud	193	252
L. sand	252	289
Blue clay	289	336
slush	336	377
Blue clay	377	481
slush	481	542
lime sand	542	571
cl. sand	571	609

NOV 9 8 1975

If well telescopes please sketch and show depths.

GROUND LEVEL

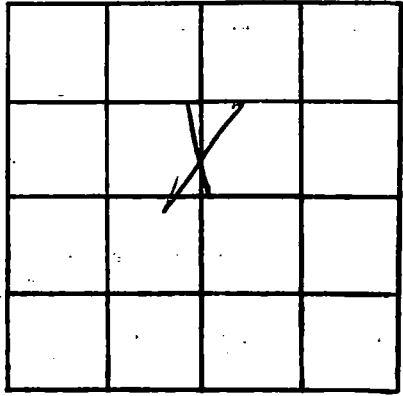

SECTION 22

Please indicate well location X.

ADDITIONAL INFORMATION

If more than one screen, show locations of each on sketch.