

HARRISON  
E 2005

11-9-76

11/19/76

MISSISSIPPI  
BOARD OF WATER COMMISSIONERS  
416 North State Street  
Jackson, Mississippi 39201

WATER WELL DRILLERS LOG  
COASTAL DRILLING & SERVICE CO.

ROUTE 1 BOX 618

Harrison  
county well located

LANDOWNER

School  
Lizama School  
(mailing address)

WELL LOCATION:

sec. 12 T. 6 N. R. 13 E.  
S. W.  
Lizama School  
(distance) (direction) (nearest town)

WELL PURPOSE:

School  
(home, irrigation, municipal, industrial)

WELL COMPLETION DATA:

- (1) diameter (inches) 4"
- (2) total depth (feet) 260'
- (3) static water level (feet) 160' below top of ground
- (4) casing 240' (material) (depth)
- (5) screen 20' (length), 240' (depth to top), 4" (size), SS (material)
- (6) pump 5 (HP), 70 (yield gpm), Ele (type power)
- (7) electric log no (yes or no)

(organization running log)

(8) how well bottom plugged

Good with water

DRILLERS REMARKS:

Very good well


Description of formations encountered	from	to
Top Soil	1	3
Red Clay	3	15
White Sand	15	40
Red Clay	40	65
White Sand	65	105
hard Blue	105	140
fine white sand	140	160
hard Blue Clay	160	185
fine white sand	185	225
Coarse white sand	225	260

RECEIVED  
FEB - 4 1977

MISS. BD. OF WATER COMMISSIONERS

If well telescopes please sketch and show depths.

GROUND LEVEL

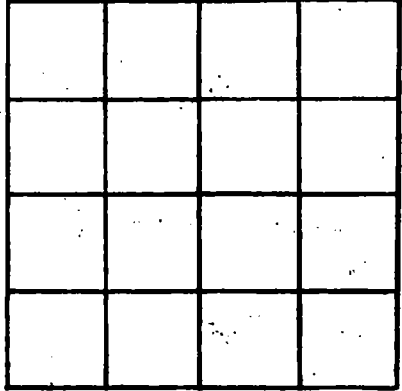

SECTION \_\_\_\_\_

Please indicate well location X.

ADDITIONAL INFORMATION

If more than one screen, show locations of each on sketch.