

HARRISON

E 2011

6-22-78

MISSISSIPPI BOARD OF WATER COMMISSIONERS 416 North State Street Jackson, Mississippi 39201

WATER WELL DRILLERS LOG

date well completed 6-22-78 firm name McMillan well works Harrison county well located Harrison

LANDOWNER: Joe Rodrick

Rt. 1, Box 625 B

P.C. Ms.

(mailing address)

WELL LOCATION:

sec 29 T 6 N R 13 E 2 miles S.E. of Vidalia (distance) (direction) (nearest town)

WELL PURPOSE: Domestic (home, irrigation, municipal, industrial)

WELL COMPLETION DATA:

- (1) diameter (inches) 2"
(2) total depth (feet) 400'
(3) static water level (feet) 90' below top of ground
(4) casing Sch. 40 390' (material) (depth)
(5) screen 10' (length) (depth to top) 2" (size) plastic (material)
(6) pump 1 (HP) 6 (yield gpm) electric (type power)
(7) electric log no (yes or no)

(organization running log)


(8) how well bottom plugged Sand Shark

DRILLERS REMARKS:

description of formations encountered

from to

Table with 3 columns: description of formations encountered, from, to. Rows include: Mud (0-140), Mud Sand (140-160), Mud Sand (160-260), Mud (260-320), Sand Muddy (320-360), S. Sand (360-380), C. Sand (380-400)

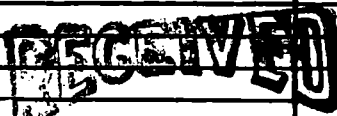


NOV 28 1978

MISS. BD. OF WATER COMM

If well telescopes please sketch and show depths.

GROUND LEVEL

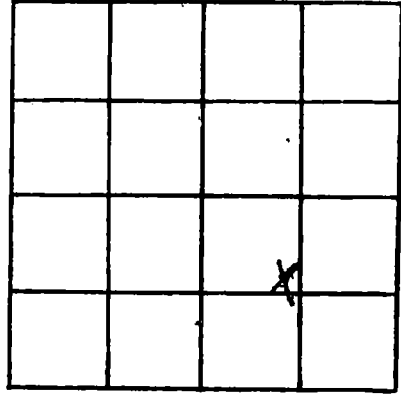

SECTION 29

Please indicate well location X.

ADDITIONAL INFORMATION

If more than one screen, show locations of each on sketch.