

HARRISON

E 2012

8-24-78

MISSISSIPPI
 BOARD OF WATER COMMISSIONERS
 416 North State Street
 Jackson, Mississippi 39201

WATER WELL DRILLERS LOG

August 24 1978
date well completed

R Lyman Well Co.
firm name

Harrison
county well located

LANDOWNER: Poppy Saucier

Lizana, Miss
(mailing address)

WELL LOCATION:
 sec 12 T 6 N R 13 E
 20 miles NW of Gulfport
 (distance) (direction) (nearest town)

WELL PURPOSE: Home
(home, irrigation, municipal, industrial)

- WELL COMPLETION DATA:
- (1) diameter (inches) 2in
 - (2) total depth (feet) 640 ft
 - (3) static water level (feet) 105 below top of ground.
 - (4) casing 2in (material), 620 (depth)
 - (5) screen 20 ft (length), 620 (depth to top)
2in slot PVC (size) (material)
 - (6) pump NA (HP), NA (yield gpm)

- (7) electric log no (yes or no)
no (organization running log)
- (8) how well bottom plugged sand Shank

description of formations encountered	from to	
red clay	0	30
red sand & mud	30	70
gray & white clay	70	140
blue clay	140	520
salt & pepper sand	520	640

RECEIVED


SEP 11 1978

DRILLERS REMARKS:

MISS. BD. OF WATER COMM

If well telescopes please sketch and show depths.

GROUND LEVEL

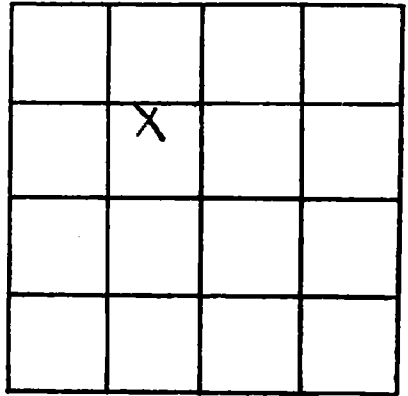

SECTION 12

Please indicate well location X.

ADDITIONAL INFORMATION

If more than one screen,
show locations of each on sketch.