

HARRISON
E 2016
4-10-79

MISSISSIPPI
BOARD OF WATER COMMISSIONERS
 416 North State Street
 Jackson, Mississippi 39201

WATER WELL DRILLERS LOG
COASTAL DRILLING & SERVICE CO.

4/10/79
 date well completed 19

ROUTE 1 BOX 618 Franklin
 county well located

LANDOWNER: Carl Leggett
Off Merge Ave
Spt Min
 (mailing address)

description of formations encountered	from	to
<u>topsoil</u>	<u>1</u>	<u>3</u>
<u>Red Clay</u>	<u>3</u>	<u>30</u>
<u>Super Sand</u>	<u>30</u>	<u>60</u>
<u>S. Blue Clay</u>	<u>60</u>	<u>210</u>
<u>hard Blue Clay</u>	<u>210</u>	<u>380</u>
<u>fine water sand</u>	<u>380</u>	<u>390</u>
<u>good water sand</u>	<u>390</u>	<u>420</u>

WELL LOCATION:
 sec 34 T 6 N R 13 E
Sandy Creek
 (distance) (direction) (nearest town)

WELL PURPOSE: home
 (home, irrigation, municipal, industrial)

- WELL COMPLETION DATA:
- (1) diameter (inches) 2"
 - (2) total depth (feet) 420'
 - (3) static water level (feet) 80 below top of ground.
 - (4) casing PVC 410'
 (material) (depth)
 - (size) If telescope see back.
 - (5) screen 10' 410'
 (length) (depth to top)
 - (size) 2" (material) PVC
 - (6) pump 1 1/2 14
 (HP) (yield gpm)
 - (type power) Ele
 - (7) electric log no
 (yes or no)
 - (organization running log)

(8) how well bottom plugged
2 1/2 inch water valves
 DRILLERS REMARKS: 19-B


Miss. Board of Water Comm.

JUN 15 1979

RECEIVED

If well telescopes please sketch and show depths.

GROUND LEVEL

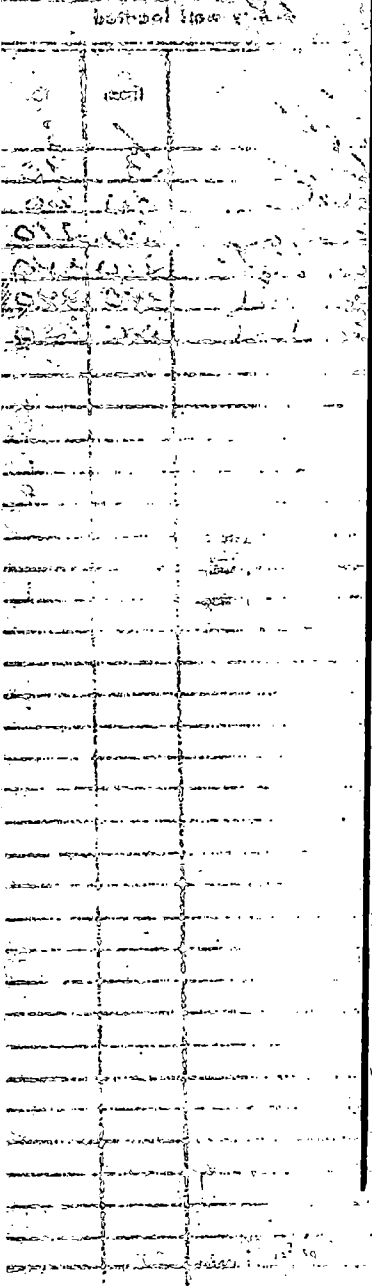

If more than one screen, show locations of each on sketch.

1	2	3	4
5	6	7	8
9	10	11	12
13	14	15	16

SECTION

Please indicate well location X:

ADDITIONAL INFORMATION

1. 100 ft

2. 100 ft

3. 100 ft

