

HARRISON  
E 2017  
3-5-79

MISSISSIPPI  
BOARD OF WATER COMMISSIONERS  
416 North State Street  
Jackson, Mississippi 39201

WATER WELL DRILLERS LOG

March 5 1979 Duncan Well Drilling Harrison  
date well completed firm name county well located

LANDOWNER: <u>Bobby Coleman</u>	description of formations encountered		from	to
<u>P.O. 441</u>	<u>Red Clay</u>		<u>0</u>	<u>30</u>
<u>Hulfport, Mo.</u> (mailing address)	<u>Blue Clay</u>		<u>30</u>	<u>180</u>
WELL LOCATION: sec. <u>2</u> T. <u>6</u> S. R. <u>13</u> E. W. <u>3</u>	<u>fine sand</u>		<u>180</u>	<u>200</u>
<u>10 1/2</u> miles <u>W.</u> of <u>Luzena</u>	<u>Course Sand</u>		<u>200</u>	<u>235</u>
(distance) (direction) (nearest town)				
WELL PURPOSE: <u>Home</u> (home, irrigation, municipal, industrial)				
WELL COMPLETION DATA:				
(1) diameter (inches) <u>2"</u>				
(2) total depth (feet) <u>235'</u>				
(3) static water level (feet) <u>40'</u> <u>below</u> top of ground.				
(4) casing <u>pvc</u> , <u>215</u> (material) (depth)				
<u>2"</u> (size) if telescope see back.				
(5) screen <u>10</u> , <u>215</u> (length) (depth to top)				
<u>2"</u> (size), <u>pvc</u> (material)				
(6) pump <u>1</u> , <u>14</u> (HP) (yield gpm)				
<u>electric</u> (type power)				
(7) electric log _____ (yes or no)				
_____ (organization running log)				
(8) how well bottom plugged <u>sand</u>				
<u>Mark</u>				
DRILLERS REMARKS:				


Miss. Board of Water Comm.

JUN - 5 1979

RECEIVED

If well telescopes please sketch and show depths.

GROUND LEVEL

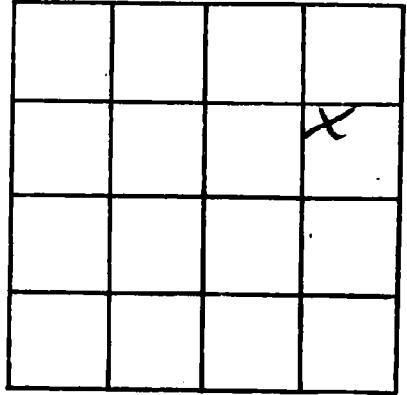

SECTION 8

Please indicate well location X.

ADDITIONAL INFORMATION

If more than one screen,  
show locations of each on sketch.