

MISSISSIPPI DEPARTMENT OF NATURAL RESOURCES

Bureau of Land and Water Resources

Southport Mall

P.O. Box 10631

Jackson, Mississippi 39209

WATER WELL DRILLERS LOG

HARRISON  
E 2024  
9-3-81

Sept. 3 1981 Duncan Well Drilling Harrison  
date well completed firm name county well located

LANDOWNER: Hub Shaddy  
P.O. Box 69  
Pass Christian  
(mailing address)

description of formations encountered	from	to
Clay	0	18
Sand	18	120
Blue Clay	120	490
fine sand	490	525
coarse sand	525	567

WELL LOCATION:  
sec 30 T 6 N 1 R 13 E  
12 miles N of Wicks  
(distance) (direction) (nearest town)

WELL PURPOSE: Home  
(home, irrigation, municipal, industrial)

WELL COMPLETION DATA:

(1) diameter (inches) 2"

(2) total depth (feet) 567 ft

(3) static water level (feet) 25' <sup>below</sup> above top of ground.

(4) casing PVC, 557'  
(material) (depth)

— if telescope see back.  
(size)

(5) screen 10', 557'  
(length) (depth to top)

2", PVC  
(size) (material)

(6) pump 1, 12  
(HP) (yield gpm)

electric  
(type power)

(7) electric log —  
(yes or no)

—  
(organization running log)

(8) how well bottom plugged Good  
Shady


MISSISSIPPI DEPARTMENT OF NATURAL RESOURCES  
BUREAU OF LAND AND WATER RESOURCES  
OCT 19 1981

RECEIVED

DRILLERS REMARKS: —

If well telescopes please sketch and show depths.

GROUND LEVEL

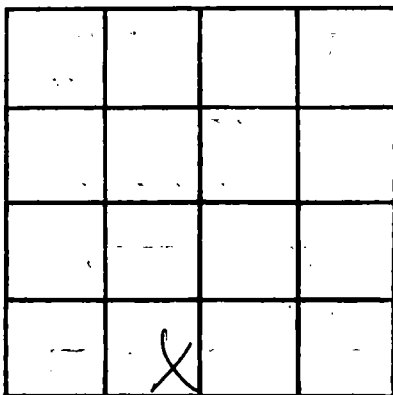

SECTION 30

Please indicate well location X.

ADDITIONAL INFORMATION

If more than one screen, show locations of each on sketch.