

MISSISSIPPI DEPARTMENT OF NATURAL RESOURCES

Bureau of Land and Water Resources

Southport Mall

P.O. Box 10631

Jackson, Mississippi 39209

WATER WELL DRILLERS LOG

HARRISON
E 2026
8/28/81

8/28/81 date well completed 19 Lipman Well Co. firm name Harrison county well located

LANDOWNER: Mr. Cuevas
Cemetery Rd.
Lancaster, MS
(mailing address)

description of formations encountered	from	to
yellow clay	0	5
Red & grey clay	5	18
Clays blue	18	110
SAND fine	110	165

WELL LOCATION:
sec. 22 6 N R 13 E
4 miles W of Lizana
(distance) (direction) (nearest town)

WELL PURPOSE: Home
(home, irrigation, municipal, industrial)

WELL COMPLETION DATA:

- (1) diameter (inches) 2"
- (2) total depth (feet) 165
- (3) static water level (feet) 31 below top of ground
- (4) casing PVC, 155' (material), (depth)
2" (size) if telescope see back.
- (5) screen 10', 155' (length), (depth to top)
2" (size), PVC (material)
- (6) pump 0 (HP), 0 (yield gpm)
electric (type power)
- (7) electric log No (yes or no)
NO (organization running log)
- (8) how well bottom plugged sand seal

DEPT. OF NATURAL RESOURCES
BUREAU OF LAND & WATER RESOURCES


OCT 20 1981

RECEIVED

DRILLERS REMARKS:

If well telescopes please sketch and show depths.

GROUND LEVEL

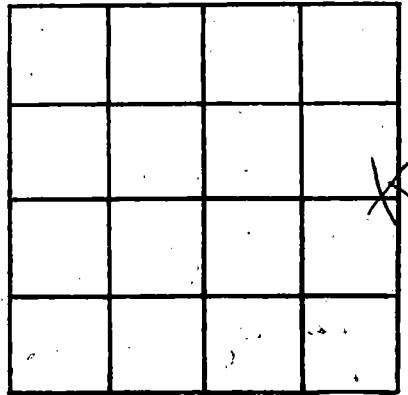

SECTION 22

Please indicate well location X.

ADDITIONAL INFORMATION

If more than one screen,
show locations of each on sketch.